


STATE OF KANSAS
STATE CORPORATION COMMISSION

WELL PLUGGING RECORD

Give All Information Completely
Make Required Affidavit
Mail or Deliver Report to:
Conservation Division
State Corporation Commission
211 No. Broadway
Wichita, Kansas

Stafford County, Sec. 26 Twp. 21 Rge. (E) 12 (W)

Location as "NE/CNW%SW%" or footage from lines NW NE SE
Lease Owner Thos. H. Allan & Shawver-Armour
Lease Name Widener Well No. 1
Office Address 925 Union Center, Wichita 2, Kansas
Character of Well (completed as Oil, Gas or Dry Hole) Dry Hole
Date well completed November 27 1956
Application for plugging filed November 27 1956
Application for plugging approved November 27 1956
Plugging commenced November 27 1956
Plugging completed November 27 1956
Reason for abandonment of well or producing formation Dry Hole

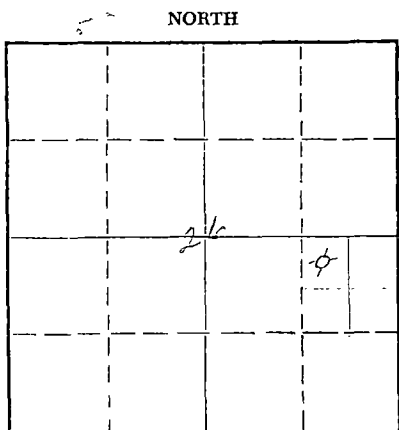

Locate well correctly on above
Section Plat

If a producing well is abandoned, date of last production 19
Was permission obtained from the Conservation Division or its agents before plugging was commenced? Yes

Name of Plugging Contractor who supervised plugging of this well R. M. Brundege
Producing formation _____ Depth to top _____ Bottom _____ Total Depth of Well 3655 Feet
Show depth and thickness of all water, oil and gas formations.

OIL, GAS OR WATER RECORDS

CASING RECORD

FORMATION	CONTENT	FROM	TO	SIZE	PUT IN	PULLED OUT
				8 5/8	233'	None

Describe in detail the manner in which the well was plugged, indicating where the mud fluid was placed and the method or methods used in introducing it into the hole. If cement or other plugs were used, state the character of same and depth placed, from _____ feet to _____ feet for each plug set.

3655 - 210 Heavy Rotary Mud
210 - 170 Wood plug bridge and 20 sacks of cement dumped through drill pipe
170 - 40 Mud
40 - Surface Bridge of sack of hulls, rock and 10 sacks of cement

(If additional description is necessary, use BACK of this sheet)

Name of Plugging Contractor Thos. H. Allan
Address 925 Union Center, Wichita 2, Kansas

STATE OF KANSAS, COUNTY OF SEDGWICK, ss.
Thos. H. Allan (owner or operator) of the above-described well, being first duly sworn on oath, says: That I have knowledge of the facts, statements, and matters herein contained and the log of the above-described well as filed and that the same are true and correct. So help me God.

(Signature) Thos. H. Allan
925 Union Center, Wichita 2, Kansas (Address)

SUBSCRIBED AND SWORN TO before me this 29th day of November, 1956

Ocie M. Stewart
RECEIVED
STATE CORPORATION COMMISSION Notary Public.

My commission expires June 14, 1958

DEC 3 - 1956
PLUGGING
FILED SEC. 26 T. 21 R. 12W
Wichita, Kansas
BOOK PAGE 120 LINE 27

8 5/8" @ 233' - 225 Sx

Allan & Shawver-Armour - #1 WIDENER
 NW NE SE 26-21-12W
 Stafford County, Kansas
 COMM: 11/15/56 COMPL: 11/27/56
 CONTRACTOR - Tom Allan
 ELEV: 1828 RB

I.P. D & A

All Depths From Rotary Bushings

- 0 - 45 Soil & Sand
- 140 Coarse Gravel
- 160 Yellow Clay
- 190 Blue Gumbo
- 233 Red Beds
- 596 Red Shale
- 616 Anhydrite
- 850 Red Shale
- 1000 Shale
- 1300 Salt & Shale
- 1500 Shale & Anhydrite
- 1825 Shale & Lime
- 1858 Fossiliferous Lime
- 1865 Red Shale
- 2200 Shale & Shells
- 2800 Shale
- 3110 Lime
- 3114 Black Shale
- 3120 Lime
- 3136 Shale
- 3145 Lime
- 3240 Shale
- 3245 Brown Lime
- 3259 Shale
- 3300 Lime
- 3325 Lime & Shale
- 3352 Lime
- 3355 Oolitic Lime
- 3398 Lime
- 3401 Oolitic Lime
- 3435 Lime
- 3440 Porous Oolitic Lime
- 3450 Lime
- 3457 Shale
- 3503 Lime
- 3513 Shale
- 3518 Lime
- 3548 Red Shale, Little Vari Color Chert
- 3592 White Weathered & Vitreous Chert
 S. Show dark oil
- 3638 Green & Red Shale
- 3655 (T.D.) Buff Crystalline Dolomite
 Porous with pet. residue

FORMATION TOPS

Anhydrite	596
Base Florence Flint	1858
Heebner	3110
Brown Lime	3240
Lansing	3259
Conglomerate	3518
Viola Chert	3548
Simpson	3592
Arbuckle	3638

I certify that the above is a true and correct copy of the well log on the above test.

Tom Allan

Subscribed and sworn to before me this 30th day of November, 1956

Oris M. Stewart
 Notary Public

My Commission expires June 14, 1958.

D.ST. 3551-3593
 20' Mud/60 Min.
 B.H.P. 50#/45 Min.

Ran Halliburton Elec. Log

RECEIVED
 STATE CORPORATION COMMISSION
 DEC 3 - 1956
 CONSERVATION DIVISION
 Wichita, Kansas

PLUGGING
 FILE: SEC. 26 T. 21 R. 12W
 BOOK PAGE 120 LINE 27