

STATE OF KANSAS
STATE CORPORATION COMMISSION

WELL PLUGGING RECORD

Give All Information Completely
Make Required Affidavit
Mail or Deliver Report to:
Conservation Division
State Corporation Commission
800 Bitting Building
Wichita, Kansas

Pawnee County, Sec. 33 Twp. 21S Rge. 16W (E) (W)

Location as "NE/CNW/SW" or footage from lines NE/4 SE/4 SW/4

Lease Owner Rocket Drilling Company, Inc.

Lease Name Larned Townsite Unit 2 Well No. 1

Office Address 352 North Broadway, Wichita, Kansas

Character of Well (completed as Oil, Gas or Dry Hole) Dry Hole

Date well completed April 28 1956

Application for plugging filed " 19 " "

Application for plugging approved April 30 19 " "


Plugging commenced April 28 19 " "

Plugging completed " 19 " "

Reason for abandonment of well or producing formation Non-Productive

If a producing well is abandoned, date of last production 19

Was permission obtained from the Conservation Division or its agents before plugging was commenced? Yes

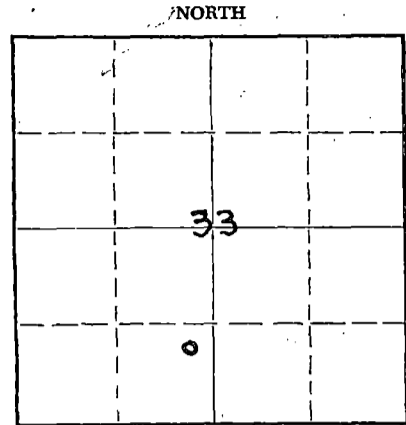

Locate well correctly on above Section Plat

Name of Conservation Agent who supervised plugging of this well Mr. R. M. Brundege

Producing formation _____ Depth to top _____ Bottom _____ Total Depth of Well 3891 Feet

Show depth and thickness of all water, oil and gas formations.

OIL, GAS OR WATER RECORDS

CASING RECORD

FORMATION	CONTENT	FROM	TO	SIZE	PUT IN	PULLED OUT
				8-5/8	984'	-0-

Describe in detail the manner in which the well was plugged, indicating where the mud fluid was placed and the method or methods used in introducing it into the hole. If cement or other plugs were used, state the character of same and depth placed, from _____ feet to _____ feet for each plug set.

Plug @ 990' with 20 sacks cement; plug @ 350' with 20 sacks cement; Plug @ 35' with 10 sacks cement

(If additional description is necessary, use BACK of this sheet)

Name of Plugging Contractor Rocket Drilling Company, Inc.

Address 352 North Broadway, Wichita, Kansas

STATE OF KANSAS, COUNTY OF SEDGWICK, ss.

L. H. Myrick

(employee of owner) or (owner or operator) of the above-described

well, being first duly sworn on oath, says: That I have knowledge of the facts, statements, and matters herein contained and the log of the above-described well as filed and that the same are true and correct. So help me God.

(Signature)

L. H. Myrick

352 North Broadway, Wichita, Kansas

(Address)

SUBSCRIBED AND SWORN TO before me this 1 day of May, 1956

My commission expires 10/28/1959


James Helmer Sense Notary Public.

RECEIVED
STATE CORPORATION COMMISSION

MAY 27 1956

CONSERVATION DIVISION
Wichita, Kansas

PLUGGING
FILE SEC 33 T 21 R 16W
BOOK PAGE 58 LINE 4

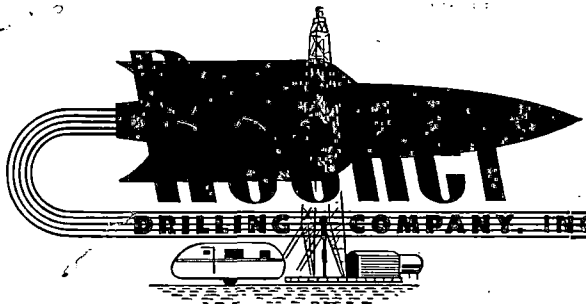

15.145.00970.0000

DRILLING COMPANY, INC. Forest 3-1279 352 N. BROADWAY WICHITA, KANSAS

Rocket Drilling Company, Inc.
 #1 Larned Townsite Unit 2
 Approx. NE/4 SE/4 SW/4 Sec. 33-215-16W
 Pawnee County, Kansas

Elevation: 1991 Gr.; 1994 D.F.; 1996 R.B.
 Spudded: April 18, 1956
 Rotary Completed: April 28, 1956
 Contractor: Rocket Drilling Company, Inc.

CASING RECORD

984' of 8-5/8" O.D. 24# seamless casing cemented with 425 sacks cement.

DRILLERS LOG

Sand	0 to 85	Lime	2015
Clay & Sand	105	Sand	2025
Clay & Shale	325	Lime	2180
Sand	350	Sand	2195
Shale	417	Lime	2415
Sand	530	Sand	2425
Shale	580	Lime & Shale	2505
Sand	610	Shale & Lime	2710
Shale	900	Shale	2885
Red Shale	976	Shale & Lime	3140
Anhydrite	1005	Lime & Shale	3545
Shale & Shells	1405	Lime	3765
Shale & Salt	1760	Lime & Shale	3825
Lime	1850	Conglomerate	3881
Lime & Shale	1965	Arbuckle	3891 T.D.

STATE OF KANSAS)
) SS:
 COUNTY OF SEDGWICK)

I hereby certify that to the best of my knowledge and belief, the foregoing log is true and correct.

ROCKET DRILLING COMPANY, INC.

L. H. Myrick
 L. H. Myrick

Subscribed and sworn to before me, a Notary Public, in and for the County and State aforesaid, this 30th day of April, 1956.

My commission expires:
 10/28/1959

Jeanne Helmer Spence
 Notary Public

CONSERVATION DIVISION
 Wichita, Kansas

PLUGGING
 FILE SEC 33 T 21 R 16W
 BOOK PAGE 58 LINE 4