


WELL PLUGGING RECORD

Give All Information Completely  
Make Required Affidavit  
Mail or Deliver Report to:  
Conservation Division  
State Corporation Commission  
800 Bittling Building  
Wichita, Kansas

Pawnee County, Sec. 33 Twp. 21S Rge. 16W (E) (W)

Location as "NE/CNW/SW" or footage from lines NW SE SW  
Lease Owner Rocket Drilling Company, Inc.  
Lease Name Larned Townsite Unit 5 Well No. 1  
Office Address 352 North Broadway, Wichita, Kansas  
Character of Well (completed as Oil, Gas or Dry Hole) Dry Hole  
Date well completed July 23 19 56  
Application for plugging filed July 23 19 ""  
Application for plugging approved July 24 19 ""  
Plugging commenced July 23 19 ""  
Plugging completed July 23 19 ""  
Reason for abandonment of well or producing formation Non-Productive

NORTH

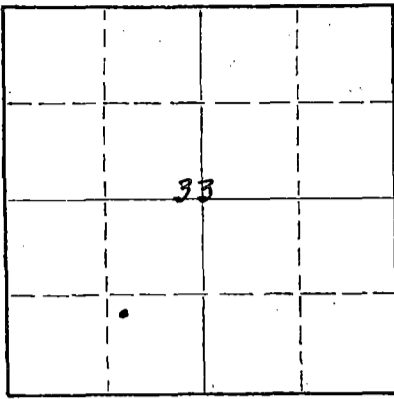

Locate well correctly on above Section Plat

If a producing well is abandoned, date of last production \_\_\_\_\_ 19\_\_\_\_  
Was permission obtained from the Conservation Division or its agents before plugging was commenced? Yes

Name of Conservation Agent who supervised plugging of this well Mr. R. M. Brundege  
Producing formation \_\_\_\_\_ Depth to top \_\_\_\_\_ Bottom \_\_\_\_\_ Total Depth of Well 3872 Feet  
Show depth and thickness of all water, oil and gas formations.

OIL, GAS OR WATER RECORDS

CASING RECORD

| FORMATION | CONTENT | FROM | TO | SIZE  | PUT IN | PULLED OUT |
|-----------|---------|------|----|-------|--------|------------|
|           |         |      |    | 8-5/8 | 981'   | -0-        |
|           |         |      |    |       |        |            |
|           |         |      |    |       |        |            |
Describe in detail the manner in which the well was plugged, indicating where the mud fluid was placed and the method or methods used in introducing it into the hole. If cement or other plugs were used, state the character of same and depth placed, from \_\_\_\_\_ feet to \_\_\_\_\_ feet for each plug set.

Placed plug @ 990'. Mixed 30 sacks cement and pumped thru drill pipe on top of plug. Filled hole with mud to 330'. Mixed 20 sacks cement and pumped thru drill pipe on top of plug and 1/3 sack hulls. Filled hole with mud to 35'. Set plug and hulls and mixed 10 sacks cement and pumped on top of same.

(If additional description is necessary, use BACK of this sheet)  
Name of Plugging Contractor Rocket Drilling Company, Inc.  
Address 352 North Broadway, Wichita, Kansas

STATE OF Kansas, COUNTY OF Sedgwick, ss.  
L. H. Myrick (employee of owner) or XXXXXXXXXX of the above-described well, being first duly sworn on oath, says: That I have knowledge of the facts, statements, and matters herein contained and the log of the above-described well as filed and that the same are true and correct. So help me God.


(Signature) LH Myrick  
352 North Broadway, Wichita, Kansas (Address)

SUBSCRIBED AND SWORN TO before me this 26 day of July, 19 56  
Jeanne Selmer Sence Notary Public.

My commission expires 10/28/1959

PLUGGING  
FILE SEC 33 T 21 R 16W  
BOOK PAGE 83 LINE 12

RECEIVED  
CORPORATION COMMISSION  
JUL 27 1956  
CONSERVATION DIVISION  
WICHITA, KANSAS

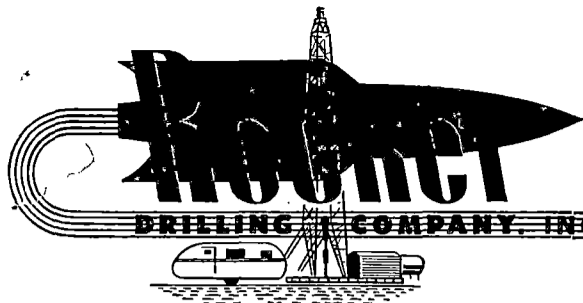

DRILLING COMPANY, INC. (Oral 3-12-79) 352 N. BROADWAY WICHITA, KANSAS

Rocket Drilling Company, Inc.  
 #1 Larned Townsite Unit #5  
 C NW/4 SE/4 SW/4 Section 33-21S-16W  
 Pawnee County, Kansas

Elevation: 1991 Gr.; 1994 D.F.; 1996 R.B.  
 Spudded: July 14, 1956  
 Rotary Completed: July 23, 1956  
 Contractor: Rocket Drilling Company, Inc.

CASING RECORD

981' 3-5/8" O.D. 24# seamless casing cemented with 390 sacks cement.

DRILLERS LOG

|                |   |    |      |                    |           |
|----------------|---|----|------|--------------------|-----------|
| Sand           | 0 | to | 80   | Sand               | 2195      |
| Shale          |   |    | 90   | Lime               | 2270      |
| Clay & Shale   |   |    | 415  | Lime & Shale       | 2420      |
| D Sand         |   |    | 525  | Sand               | 2430      |
| Shale          |   |    | 575  | Shale & Lime       | 2800      |
| Sand           |   |    | 625  | Shale              | 2865      |
| Shale          |   |    | 975  | Sand               | 2875      |
| Anhydrite      |   |    | 1005 | Shale & Lime       | 3105      |
| Shale & Shells |   |    | 1380 | Lime               | 3339      |
| Shale & Salt   |   |    | 1825 | Lime & Shale       | 3526      |
| Shale & Lime   |   |    | 1970 | Lime               | 3745      |
| Lime           |   |    | 2015 | Lime & Shale       | 3825      |
| Sand           |   |    | 2025 | Shale              | 3848      |
| Lime           |   |    | 2080 | Simpson & Arbuckle | 3863      |
| Sand           |   |    | 2090 | Arbuckle           | 3872 T.D. |
| Lime           |   |    | 2185 |                    |           |

STATE OF KANSAS )  
 ) SS  
 COUNTY OF SEDGWICK )

I hereby certify that to the best of my knowledge and belief, the foregoing log is true and correct.

ROCKET DRILLING COMPANY, INC.

*L. R. Myrick*  
 L. R. Myrick

Subscribed and sworn to before me, a Notary Public, in and for the County and State aforesaid, this 26th day of July, 1956.

*Jessie Helmer Spence*  
 Notary Public

My commission expires:  
 10/28/1959

**PLUGGING**  
 FILE SEC. 33 T. 21 R. 16W  
 BOOK PAGE 83 LINE 12

STATE CORPORATION COMMISSION

JUL 27 1956  
 CONCERNED OFFICE