


STATE OF KANSAS
STATE CORPORATION COMMISSION

WELL PLUGGING RECORD

Give All Information Completely
Make Required Affidavit
Mail or Deliver Report to
Conservation Division
State Corporation Comm.
245 North Water
Wichita, KS 67202

PAWNEE County. Sec. 20 Twp. 20s Rge. 19W E/V
Location as "NE/CNW/SW" or footage from lines
190' West of C-SE-NW-SW
Lease Owner Wenert Trich
Lease Name Bartonek Well No. 1
Office Address P.O. Box 1408, Longview, TX 75606
Character of Well (Completed as Oil, Gas or Dry Hole)
Dry and Abandoned

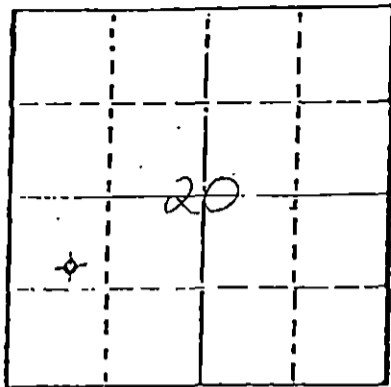

Date Well completed 11-24-84 19
Application for plugging filed 1-14-85 19
Application for plugging approved 19
Plugging commenced 11-19-84 19
Plugging completed 11-24-84 19
Reason for abandonment of well or producing formation
Non Productive

If a producing well is abandoned, date of last production
NA 19

Was permission obtained from the Conservation Division or
its agents before plugging was commenced? Yes

Name of Conservation Agent who supervised plugging of this well Steve Durant
Producing formation NA Depth to top NA Bottom NA Total Depth of Well 4320'
Show depth and thickness of all water, oil and gas formations.

OIL, GAS OR WATER RECORDS

CASING RECORD

FORMATION	CONTENT	FROM	TO	SIZE	PUT IN	PULLED OUT
Surface Casing	13 jts.	0	554'	8 5/8ths		

Describe in detail the manner in which the well was plugged, indicating where the mud fluid
was placed and the method or methods used in introducing it into the hold. If cement or other
plugs were used, state the character of same and depth placed, from _____ feet to
_____ feet for each plug set.

First plug at 1350' with 50 sacks 60/40 pozmix.

Second plug at 600' with 50 sacks "

Third plug at 40' with 10 sacks "

15 sacks in rat hole.

(If additional description is necessary, use BACK of this sheet)

Name of Plugging Contractor Sun Cementers

STATE OF Texas COUNTY OF Treggs ss.
Nathan Trich (employee of owner) or (owner or operator)
of the above-described well, being first duly sworn on oath, says: That I have knowledge of
the facts, statements, and matters herein contained and the log of the above-described well
as filed and that the same are true and correct. So help me God.

(Signature)

Nathan Trich
P.O. Box 1408, Longview, TX 75606
(Address)

SUBSCRIBED AND SWORN TO before me this 14th day of January, 1985

Jill Marie Smith
Notary Public.

My commission expires 6-11-86

RECEIVED
STATE CORPORATION COMMISSION

JAN 17 1985

CONSERVATION DIVISION
Wichita, Kansas

