

WELL PLUGGING RECORD

Give All Information Completely  
Make Required Affidavit  
Mail or Deliver Report to:  
Conservation Division  
State Corporation Commission  
211 No. Broadway  
Wichita, Kansas

Pawnee

County. Sec. 8 Twp. 20 S Rge. (E) 19 (W)

Location as "NE/CNW&SW%" or footage from lines SW/4 SW/4 NE/4

Lease Owner Messman-Rinehart Oil Company

Lease Name Seeman Well No. 1

Office Address 518 Petroleum Building, Wichita, Kansas

Character of Well (completed as Oil, Gas or Dry Hole) Dry Hole

Date well completed May 31, 1959

Application for plugging filed May 31, 1959

Application for plugging approved May 31, 1959


Plugging commenced May 31, 1959

Plugging completed May 31, 1959

Reason for abandonment of well or producing formation Dry

If a producing well is abandoned, date of last production 19

Was permission obtained from the Conservation Division or its agents before plugging was commenced? Frank Broadfoot

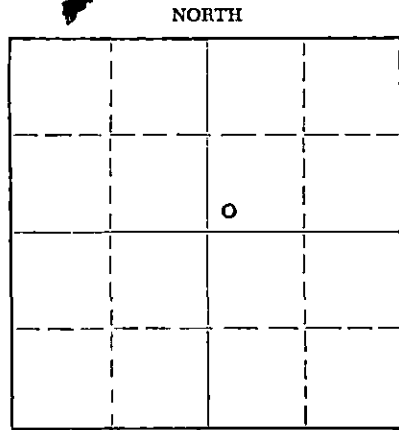

Locate well correctly on above Section Plat

Name of Conservation Agent who supervised plugging of this well \_\_\_\_\_

Producing formation \_\_\_\_\_ Depth to top \_\_\_\_\_ Bottom \_\_\_\_\_ Total Depth of Well 4305 Feet

Show depth and thickness of all water, oil and gas formations.

OIL, GAS OR WATER RECORDS

CASING RECORD

FORMATION	CONTENT	FROM	TO	SIZE	PUT IN	PULLED OUT
				10-3/4"	395'	none

Describe in detail the manner in which the well was plugged, indicating where the mud fluid was placed and the method or methods used in introducing it into the hole. If cement or other plugs were used, state the character of same and depth placed, from \_\_\_\_\_ feet to \_\_\_\_\_ feet for each plug set.

Mud to 360'. Set plug at 360' with  
1/4 sk. hulls and 25 sx. cement.  
Mud to 35'. Set plug at 35' with  
1/4 sk. hulls and 15 sx. cement.  
Mud to surface.

RECEIVED  
STATE CORPORATION COMMISSION  
AUG 7 1959  
CONSERVATION DIVISION  
Wichita, Kansas

(If additional description is necessary, use BACK of this sheet)

Name of Plugging Contractor Messman-Rinehart Oil Company

Address 518 Petroleum Building, Wichita, Kansas

STATE OF Kansas, COUNTY OF Sedgwick, ss.

J. A. Gilliland (employee of owner) or ~~owner~~ of the above-described well, being first duly sworn on oath, says: That I have knowledge of the facts, statements, and matters herein contained and the log of the above-described well as filed and that the same are true and correct. So help me God.

(Signature) J. A. Gilliland

518 Petroleum Building, Wichita, Kansas  
(Address)

SUBSCRIBED AND SWORN TO before me this 22nd day of June, 1959

Barbara J. Scott  
Barbara J. Scott, Notary Public.

My commission expires December 1, 1960

PLUGGING  
FILE SEC 8 T. 20 R. 19  
BOOK PAGE 57 LINE 10

NO. 1 SEEHANWell Record

Location: SW/4 SW/4 NE/4  
Section 8-20S-19W  
Pawnee County, Kansas

Commenced: May 19, 1959

Completed: May 31, 1959

Operator: Messman-Rinehart Oil Company  
518 Petroleum Building  
Wichita, Kansas

Elevation: 2206' K/B

Production: D & A

Contractor: Messman-Rinehart Oil Company  
518 Petroleum Building  
Wichita, Kansas

Casing Record: 10-3/4" @ 395' w/230 sx. cement

## \*\*\* LOG \*\*\*

Clay and Sand	40
Clay	90
Shale	295
Sand and Shale	365
Shale	395
Shale	770
Sand	1022
Shale and Red Bed	1330
Red Bed	1345
Anhydrite	1380
Lime and Shale	1530
Shale	1855
Shale and Lime	2135
Lime	2255
Lime	2375
Lime and Shale	2510
Lime	2605
Lime and Shale	3930
Lime	3995
Lime and Shale	4140
Lime	4160
Sand	4160
Lime and Shale	4240
Lime	4255
Lime and Chert	4305 R.T.D.

Sample Tops:

3309' - Topeka	(-1103)
3650' - Heabner	(-1444)
3668' - Toronto	(-1462)
3699' - Kansas-Kansas City	(-1493)
4032' - Base Kansas City	(-1626)
4161' - Basal Penn. Sd.	(-1955)
4204' - Cherty & Sandy Conglomerate	(-1998)
4256' - Cherty Conglomerate	(-2050)
4280' - Mississippian Chert	(-2074)

RECEIVED  
STATE CORPORATION COMMISSION

AUG 7 1959

REGISTRATION DIVISION

The undersigned, HESSMAN-RINEHART OIL COMPANY, hereby certifies that the above log is a true and correct log of the formation encountered in drilling the above well as reflected by the Daily Drilling Reports.

HESSMAN-RINEHART OIL COMPANY

By: J. A. Gilliland

J. A. Gilliland

Subscribed and sworn to before me  
this 9th day of June, 1959.

Barbara J. Scott  
Barbara J. Scott, Notary Public

My Commission Expires: December 1, 1960

