

WELL PLUGGING RECORD


Give All Information Completely
Make Required Affidavit
Mail or Deliver Report to:
Conservation Division
State Corporation Commission
800 Bitting Building
Wichita, Kansas

Pawnee

County, Sec. 8 Twp. 20 Rge. 19 (E) (W)

Location as "NE/CNW&SW" or footage from lines C SL NW
Lease Owner National Cooperative Refinery Association
Lease Name Pfenninger "A" Well No. 1
Office Address 305 Rule Building, Wichita, Kansas
Character of Well (completed as Oil, Gas or Dry Hole) Dry Hole
Date well completed May 31, 1954
Application for plugging filed June 2, 1954
Application for plugging approved June 1, 1954
Plugging commenced May 31, 1954
Plugging completed May 31, 1954
Reason for abandonment of well or producing formation Dry Hole

NORTH

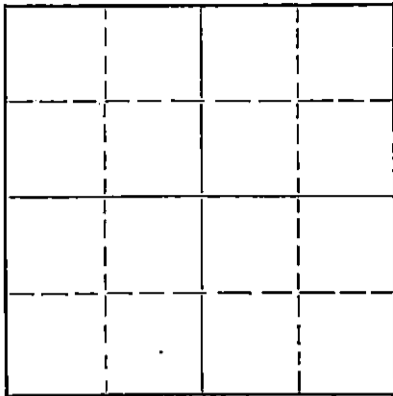

Locate well correctly on above
Section Plat

If a producing well is abandoned, date of last production 19____
Was permission obtained from the Conservation Division or its agents before plugging was commenced? Yes

Name of Conservation Agent who supervised plugging of this well Warren Horner
Producing formation _____ Depth to top _____ Bottom _____ Total Depth of Well 4376 Feet
Show depth and thickness of all water, oil and gas formations.

OIL, GAS OR WATER RECORDS

CASING RECORD

FORMATION	CONTENT	FROM	TO	SIZE	PUT IN	PULLED OUT
				8 5/8"	357'	Cemented

Describe in detail the manner in which the well was plugged, indicating where the mud fluid was placed and the method or methods used in introducing it into the hole. If cement or other plugs were used, state the character of same and depth placed, from _____ feet to _____ feet for each plug set.

Mudded hole to 300', set plug, dumped 1/2 sack hulls plus 20 sacks cement.
Mudded hole to 35', set plug, dumped 1/2 sack hulls plus 10 sacks cement
on up to base of cellar.

RECEIVED
STATE CORPORATION COMMISSION
JUN 3 - 1954
CONSERVATION DIVISION
Wichita, Kansas

(If additional description is necessary, use BACK of this sheet)
Name of Plugging Contractor Carl Todd Drilling
Address K-F-H Building, Wichita, Kansas

STATE OF Kansas, COUNTY OF Sedgwick, ss.
C. R. Sears (employee of owner) or (owner or operator) of the above-described well, being first duly sworn on oath, says: That I have knowledge of the facts, statements, and matters herein contained and the log of the above-described well as filed and that the same are true and correct. So help me God.

(Signature) C. R. Sears
305 Rule Building, Wichita, Kansas
(Address)

SUBSCRIBED AND SWORN to before me this 2 day of June, 1954

C. Orville May
Notary Public

My commission expires June 30, 1954

C. Orville May

PLUGGING
FILE SEC. 8 T. 20 R. 19 W
BOOK PAGE 32 LINE 23

THE CARL TODD DRILLING COMPANY
404 KFH Building
Wichita, Kansas

NATIONAL COOPERATIVE REFINERY ASSOCIATION

#1 Pfenninger
C S/2 S/2 NW/4 Sec. 8-20S-19W
Pawnee County, Kansas

ELEVATION: 2216 Kelly Bushing

CASING RECORD

COMMENCED: May 14, 1954
COMPLETED: May 31, 1954

Set 8-5/8" 24# casing at 356',
cemented with 200 sacks cement,
3 sacks CC

0 - 285	Shale and shells
285 - 356	Shale and lime
356 - 770	Shale, shells & Red Bed
770 - 885	Sand
885 - 975	Sand
975 - 1060	Sand and shale
1060 - 1310	Shale and shells
1310 - 1355	Red Bed
1355 - 1375	Anhydrite
1375 - 1560	Shale and Red Bed
1560 - 1870	Shale and shells
1870 - 2135	Shale and shells
2135 - 2255	Lime and shale
2255 - 2375	Lime and shale
2375 - 2495	Lime and shale
2495 - 2610	Shale
2610 - 2720	Lime
2720 - 2820	Lime and shale
2820 - 2920	Lime and shale
2920 - 3030	Lime and shale
3030 - 3190	Shale and lime
3190 - 3275	Shale and lime
3275 - 3370	Shale and lime
3370 - 3460	Shale and lime
3460 - 3493	Lime
3493 - 3570	Lime
3570 - 3645	Lime and shale
3645 - 3710	Lime
3710 - 3760	Lime
3760 - 3820	Lime
3820 - 3863	Lime
3863 - 3915	Lime
3915 - 3945	Lime
3945 - 3995	Lime
3995 - 4045	Lime
4045 - 4080	Lime and shale
4080 - 4137	Lime
4137 - 4145	Lime
4145 - 4161	Shale and Sand
4161 - 4163	Shale and lime
4163 - 4230	Sand, shale & lime
4230 - 4265	Lime and chert
4265 - 4295	Lime and shale
4295 - 4315	Lime and chert
4315 - 4350	Lime, shale & chert
4350 - 4376	Lime, shale & sand
4376	Rotary Total Depth

TOPS

Heebner	3636
Toronto	3656
Lansing	3687
B/ Kansas City	4022
Cherokee Sand	4165
Mississippi	4240
Gilmore City	4300
Kinderhook Sand	4347
Viola	4368

I hereby certify that the above is a true and correct log to the best of my knowledge and belief.

THE CARL TODD DRILLING COMPANY

BY James A. Henderson

PLUGGING
FILE SEC 8-20-19W
BOOK PAGE 27 LINE 23

RECEIVED
NATIONAL COOPERATIVE REFINERY ASSOCIATION
DIVISION
MAY 31 1954









