


STATE OF KANSAS
STATE CORPORATION COMMISSION

Give All Information Completely
Make Required Affidavit
Mail or Deliver Report to:
Conservation Division
State Corporation Commission,
800 Bitting Building
Wichita, Kansas

WELL PLUGGING RECORD
OR
FORMATION PLUGGING RECORD

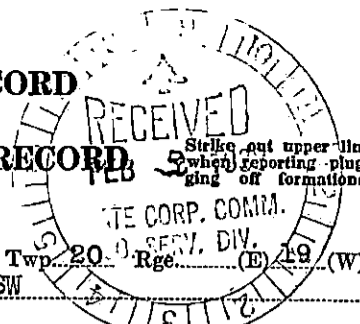

Pawnee County. Sec. 8 Twp. 20 Rge. 19 (W)

Location as "NE 1/4 NW 1/4 SW 1/4" or footage from lines c NE SW

Lease Owner Phillips Petroleum Company

Lease Name F. J. Johnson Well No. 1

Office Address Bartlesville, Oklahoma

Character of Well (Completed as Oil, Gas or Dry Hole) Dry Hole

Date, well completed 12-20 1937

Application for plugging filed 12-21 1937

Application for plugging approved 12-22 1937


Plugging Commenced 1-7 1938

Plugging Completed 1-7 1938

Reason for abandonment of well or producing formation Dry Hole

If a producing well is abandoned, date of last production 1937

Was permission obtained from the Conservation Division or its agents before plugging was commenced? Yes

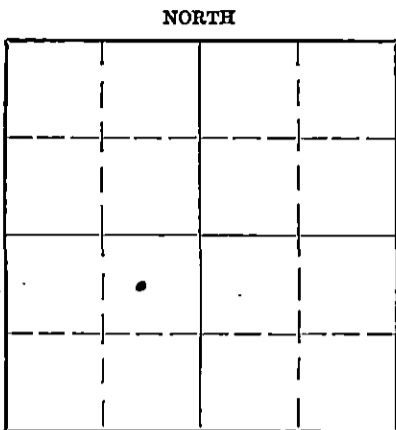

Locate well correctly on above Section Plat

Name of Conservation Agent who supervised plugging of this well C. T. Alexander

Producing formation Siliceous (Dry) Depth to top 4348 Bottom 4417 Total Depth of Well 4417 Feet

Show depth and thickness of all water, oil and gas formations.


OIL, GAS OR WATER RECORDS

CASING RECORD

Formation	Content	From	To	Size	Put In	Pulled Out
Rotary hole, core showed no saturation or porosity.				16"	202'	none

Describe in detail the manner in which the well was plugged, indicating where the mud fluid was placed and the method or methods used in introducing it into the hole. If cement or other plugs were used, state the character of same and depth placed, from _____ feet to _____ feet for each plug set.

Hole filled w/ rotary mud from bottom to 200' from surface. Set bridge @ 200' and cemented w/ 20 sacks cement, then filled to within 15' of top and cemented from there to surface.

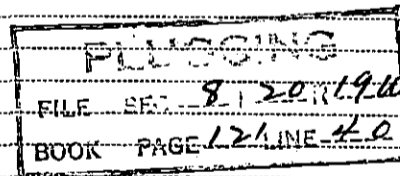

(If additional description is necessary use BACK of this sheet)

Correspondence regarding this well should be addressed to Phillips Petroleum Company
Address Bartlesville, Oklahoma

STATE OF Kansas COUNTY OF Sedgwick
C. E. Klein (employee of owner) or (owner or operator) of the above-described well,

being first duly sworn on oath, says: That I have knowledge of the facts, statements, and matters herein contained and the log of the above-described well as filed and that the same are true and correct. So help me God.

(Signature) C. E. Klein


610 Ellis Singleton Bldg. Wichita Kansas
(Address)

SUBSCRIBED AND SWORN to before me this 2 day of February, 1938.

My commission expires April 24, 1940. M. A. Miles Notary Public.

FORMATION RECORD

F. Johnson #1

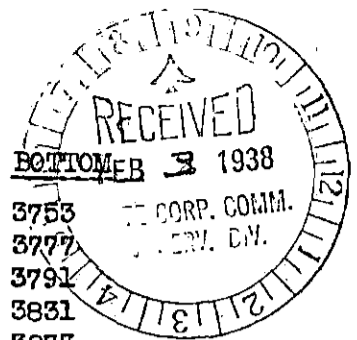

<u>FORMATION</u>	<u>BOTTOM</u>	<u>FORMATION</u>	<u>BOTTOM</u>
Surface	35	Lime	3753
Shale & Shells	315	Lime	3777
Shale & Shells	562	Lime	3791
Shale & Hard Sand	650	Lime	3831
Red Bed	772	Lime	3873
Sand	875	Lime	3883
Red Bed & Shale	1174	Lime	3905
Shale	1297	Lime	3941
Anhydrite	1323	Lime	3961
Anhydrite	1345	Lime	3993
Hard Sandy Shale	1438	Lime, Medium	4025
Shale	1541	Lime, Hard	4037
Shale & Lime Shells	1627	Lime	4044
Shale & Shells	1735	Lime	4052
Shale	1876	Lime	4056
Salt	2030	Lime	4084
Shale & Shells	2049	Lime	4110
Shale	2100	Lime	4117
Lime	2138	Lime	4129
Lime	2189	Shale	4141
Lime	2243	Lime, Hard	4143
Lime	2292	Conglomerate	4165
Broken Lime & Shale	2382	Conglomerate	4190
Lime	2439	Conglomerate	4210
Lime	2447	Conglomerate	4225
Lime	2503	Conglomerate	4235
Lime	2553	Shale	4252
Lime	2593	Chert & Lime	4255
Broken Lime	2651	Chert, Decayed	4266
Broken Lime	2701	Chert, Hard	4272
Lime	2757	Chert	4292
Lime	2787	Shale	4302
Lime	2831	Lime & Chert	4330
Shale & Lime	2881	Simpson	4335
Lime	2890	Simpson	4350
Lime	2921	Lime	4360
Lime	2955	Lime	4370
Lime	3012	Lime	4394
Lime	3030	Lime	4416
Shale	3085	Lime	4417 (Total Depth)
Lime	3094		
Lime	3100		
Shale & Shells	3140		
Lime	3154		
Lime	3194		
Lime	3196		
Lime	3241		
Lime	3300		
Lime	3339		
Broken Lime	3367		
Lime	3411		
Lime	3462		
Broken Lime	3504		
Lime	3548		
Lime	3594		
Lime	3626		
Lime	3675		
Lime	3687		
Broken Lime, Red	3696		
Blue Shale	3702		
Lime	3717		

FILED
 FILE SEC 8. 20. 1938
 BOOK PAGE 12/LINE 40