


STATE OF KANSAS
STATE CORPORATION COMMISSION

Form CP-4

Give All Information Completely
Make Required Affidavit
Mail or Deliver Report to:
Conservation Division
State Corporation Commission
P. O. Box 17027
Wichita, Kansas 67217
NORTH

WELL PLUGGING RECORD

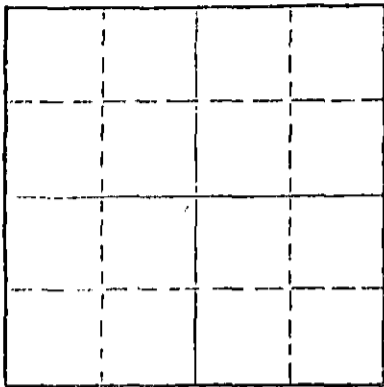

Locate well correctly on above
Section Plat

Pawnee County, Sec. 8 Twp. 20S Rge. (E) 19W (W)
Location as "NE/CNW/SW" or footage from lines 100' NW of SE NE SW
Lease Owner Rains & Williamson Oil Co., Inc.
Lease Name Pfenninger Well No. 1
Office Address 435 Page Court, 220 W. Douglas, Wichita, Ks.
Character of Well (completed as Oil, Gas or Dry Hole) Dry Hole
Date well completed 6-4 1974
Application for plugging filed 6-4 1974
Application for plugging approved 6-4 1974
Plugging commenced 6-4 1974
Plugging completed 6-4 1974
Reason for abandonment of well or producing formation No commercial
quantities of oil or gas encountered.
If a producing well is abandoned, date of last production 19
Was permission obtained from the Conservation Division or its agents before plugging was com-
menced? Yes

Name of Conservation Agent who supervised plugging of this well W. L. Nichols
Producing formation _____ Depth to top _____ Bottom _____ Total Depth of Well 4250 Feet
Show depth and thickness of all water, oil and gas formations.

OIL, GAS OR WATER RECORDS

CASING RECORD

FORMATION	CONTENT	FROM	TO	SIZE	PUT IN	PULLED OUT
Surface Hole	Water	Surface	585	8-5/8"	578	None

Describe in detail the manner in which the well was plugged, indicating where the mud fluid was placed and the method or methods used in introducing it into the hole. If cement or other plugs were used, state the character of same and depth placed, from _____ feet to _____ feet for each plug set.

Fluid to 600', plug, 35 sx cement;
Fluid to 40', plug, 10 sx cement.

RECEIVED
STATE CORPORATION COMMISSION
JUN 11 1974
CONSERVATION DIVISION
Wichita, Kansas

(If additional description is necessary, use BACK of this sheet)
Name of Plugging Contractor D N B DRILLING, INC.
Address 701 First National Bldg., Wichita, Kansas 67202

STATE OF KANSAS, COUNTY OF _____, ss.
JAMES L. DONELSON

(employee of owner) or (owner or operator) of the above-described well, being first duly sworn on oath, says: That I have knowledge of the facts, statements, and matters herein contained and the log of the above-described well as filed and that the same are true and correct. So help me God.

(Signature) James L. Donelson
701 First Nat'l Bldg., Wichita, Kansas
(Address)

Subscribed and Sworn to before me this 10th day of June, 19 74

My commission expires August 25, 1976

Ella Priess
Ella Priess
Notary Public.
STATE NOTARY PUBLIC
Sedgwick County, Kansas
My Com. Expires Aug. 25, 1976

DRILLERS' LOG

RAINS & WILLIAMSON OIL CO., INC.
No. 1 Pfenninger
100' NW of SE NE SW, Sec. 8-20S-19W
Pawnee County, Kansas

Elevation: 2198 K.B.

Commenced: 5-28-74
Completed: 6-4-74

Surface Casing: 578' of
8-5/8" cemented w/325 sx
common cement, 2% Gel, 3% cc.
5-29-74

FORMATION

DEPTH

Surface Hole	0 - 585
Shale & Shells	585 - 755
Sand	755 - 950
Red Bed	950 - 1050
Shale & Red Bed	1050 - 1330
Anhydrite	1330 - 1355
Shale	1355 - 2135
Lime & Shale	2135 - 2575
Lime	2575 - 2790
Lime & Shale	2790 - 3700
Lime	3700 - 4250 T.D.

RECEIVED
STATE CORPORATION COMMISSION
JUN 11 1974
CONSERVATION DIVISION
Wichita, Kansas

I do hereby certify that the foregoing statements are true and correct to the best of my knowledge and belief.

D. N. B. DRILLING, INC.

James L. Donelson
JAMES L. DONELSON

STATE OF KANSAS: ss:

Subscribed and sworn to before me, the undersigned, a Notary Public in and for said state, this 10th day of June, 1974.

My Commission Expires:
August 25, 1976

Ella Priess

Ella Priess, Notary Public

Ella Priess
STATE NOTARY PUBLIC
Sedgwick County, Kansas
My Com. Expires Aug. 25, 1976