


Give All Information Completely
Make Required Affidavit
Mail or Deliver Report to:
Conservation Division
State Corporation Commission
211 No. Broadway
Wichita, Kansas

WELL PLUGGING RECORD

Pawnee County, Sec. 10 Twp. 20S-Rge. 19 (W)
Location as "NE/CNW&SW&W" or footage from lines NW SW SW
Lease Owner National Cooperative Refining Association
Lease Name HAGERMAN Well No. 6
Office Address 305 Rule Building, Wichita, Kansas
Character of Well (completed as Oil, Gas or Dry Hole) Oil
Date well completed April 11, 19 55
Application for plugging filed December 6, 19 62
Application for plugging approved December 7, 19 62
Plugging commenced December 19, 19 62
Plugging completed December 21, 19 62
Reason for abandonment of well or producing formation Depletion

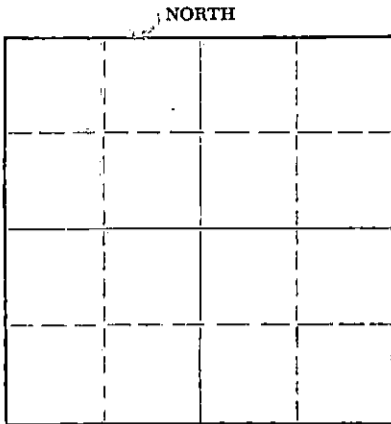

Locate well correctly on above
Section Plat

If a producing well is abandoned, date of last production December 1, 19 62
Was permission obtained from the Conservation Division or its agents before plugging was commenced? Yes

Name of Conservation Agent who supervised plugging of this well Archie Elving
Producing formation _____ Depth to top _____ Bottom _____ Total Depth of Well 4252 Feet
Show depth and thickness of all water, oil and gas formations.

OIL, GAS OR WATER RECORDS

CASING RECORD

FORMATION	CONTENT	FROM	TO	SIZE	PUT IN	PULLED OUT
				8-5/8"	135'	None
				5-1/2"	4252'	3448'

Describe in detail the manner in which the well was plugged, indicating where the mud fluid was placed and the method or methods used in introducing it into the hole. If cement or other plugs were used, state the character of same and depth placed, from _____ feet to _____ feet for each plug set.

Sanded hole to 4190 feet. Dumped 5 sacks of cement.
Shot pipe off and recovered 3448 feet of 5-1/2" casing.
Mudded hole. Built 18 foot rock bridge to 120 feet and
dumped 20 sacks of cement. Mudded hole to 10 feet and
capped well with 10 sacks of cement.

RECEIVED
STATE CORPORATION COMMISSION

JAN 17 1963

CONSERVATION DIVISION
Wichita, Kansas

(If additional description is necessary, use BACK of this sheet)

Name of Plugging Contractor Forbes Casing Pulling, Inc.
Address P. O. Box 221, Great Bend, Kansas

STATE OF Kansas, COUNTY OF Sedgwick, ss.
C. R. Sears

(employee of owner) or (owner or operator) of the above-described well, being first duly sworn on oath, says: That I have knowledge of the facts, statements, and matters herein contained and the log of the above-described well as filed and that the same are true and correct. So help me God.

(Signature) C. R. Sears (C. R. Sears)

305 Rule Building Wichita, Kansas
(Address)

SUBSCRIBED AND SWORN TO before me this 16th day of January, 19 63

My commission expires November 26, 1964

Nell McComb
Notary Public.



KANSAS GEOLOGICAL SOCIETY
KANSAS WELL LOG BUREAU - KANSAS WELL SURVEY BUREAU
KANSAS GEOLOGICAL SOCIETY BUILDING
508 EAST MURDOCK - WICHITA, KANSAS

15:145.01352.0000

COMPANY **H. B. ARMER**

SEC. 10 T. 20S R. 19W

FARM **Magnum**

NO. 6 *File*

LOC. **NV SW SW**

TOTAL DEPTH **4252**


COUNTY **Pawnee**

COMM. **3/29/55**

COMP. **4/11/55**

KANSAS

SHOT OR TREATED

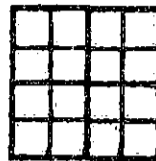

CONTRACTOR **H. B. Armer**

ISSUED

CASING

20	10	
15	8	190
12	6	
13	5	4252

ELEVATION **2338 K.B.**

PRODUCTION

FIGURED INDICATE BOTTOM OF FORMATIONS

Surface	0
Shale & Shells	200
Shale & Sand Stringers	245
Sand & Shale Stringers	310
Shale, Sand, Red Bed & Blue Shale	600
Blue Shale	710
Red Bed	790
Sand	1015
Shale & Shells	1080
Red Bed & Shale	1380
Anhydrite	1415
Shale & Shells	2060
Broken Lime	2210
Shale & Lime	3622
Lime	3701
Lime - Broken	3802
Lime	4178
Sand & Shale	4200
Cherty Congl. & Sand	4222
Sand & Shale	4252

FORMATION TOPS

HEENR	3673
TORONTO	3688
LANSING	3713
BASE KANSAS CITY	4028
CONGLOMERATE SAND	4177

RECEIVED
 STATE GEOLOGICAL SURVEY

JAN 17 1963

CONSERVATION DIVISION
 WICHITA, KANSAS

I hereby certify that this is a true and correct log of the above described well as shown by the drilling reports.

M. B. ARMER

By *[Signature]*

STATE OF KANSAS

COUNTY OF SEDGWICK

Subscribed and sworn to before me, a notary public, in and for said County and State this 18th day of April, 1955.

[Signature]
 Notary Public

My Commission Expires - February 13, 1956.

