


Give All Information Completely  
Make Required Affidavit  
Mail or Deliver Report to:  
Conservation Division  
State Corporation Commission  
211 No. Broadway  
Wichita, Kansas

WELL PLUGGING RECORD

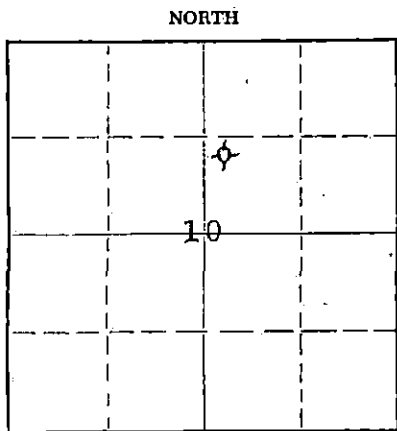

Locate well correctly on above  
Section Plat

Pawnee County. Sec. 10 Twp. 20 Rge. 19 (~~EX~~) (W)  
Location as "NE/CNW%SW%" or footage from lines NW SW NE  
Lease Owner D. R. Lauck Oil Company, Inc.  
Lease Name Josefiak Well No. 1  
Office Address 301 S. Broadway, Wichita, Kansas  
Character of Well (completed as Oil, Gas or Dry Hole) Dry Hole  
Date well completed July 30, 1961  
Application for plugging filed July 29, 1961  
Application for plugging approved July 29, 1961  
Plugging commenced July 29, 1961  
Plugging completed July 29, 1961  
Reason for abandonment of well or producing formation Dry Hole

If a producing well is abandoned, date of last production \_\_\_\_\_ 19\_\_\_\_  
Was permission obtained from the Conservation Division or its agents before plugging was commenced? Yes

Name of Conservation Agent who supervised plugging of this well Frank Broadfoot  
Producing formation \_\_\_\_\_ Depth to top \_\_\_\_\_ Bottom \_\_\_\_\_ Total Depth of Well 4290 Feet  
Show depth and thickness of all water, oil and gas formations.

OIL, GAS OR WATER RECORDS

CASING RECORD

FORMATION	CONTENT	FROM	TO	SIZE	PUT IN	PULLED OUT
		0'	270'	10-3/4"	270'	None

Describe in detail the manner in which the well was plugged, indicating where the mud fluid was placed and the method or methods used in introducing it into the hole. If cement or other plugs were used, state the character of same and depth placed, from \_\_\_\_\_ feet to \_\_\_\_\_ feet for each plug set.

Mud 4290' - 240'  
Plug 240' - 236'  
30 sx Cement & Mud 236' - 35'  
Plug 35' - 31'  
15 sx Cement 31' - 6' (Bottom of Cellar)

RECEIVED  
STATE CORPORATION COMMISSION

SEP 13 1961

CONSERVATION DIVISION  
Wichita, Kansas

(If additional description is necessary, use BACK of this sheet)

Name of Plugging Contractor Halliburton Cementing Co.  
Address Great Bend, Kansas

STATE OF KANSAS, COUNTY OF SEDGWICK, ss.  
John H. Knightley (employee of owner) or (owner or operator) of the above-described well, being first duly sworn on oath, says: That I have knowledge of the facts, statements, and matters herein contained and the log of the above-described well as filed and that the same are true and correct. So help me God.

(Signature) John H. Knightley  
301 S. Broadway, Wichita, Kansas  
(Address)

SUBSCRIBED AND SWORN TO before me this 12th day of September, 19 61

Stella J. Bodine  
Notary Public.

My commission expires March 12, 1963



D. R. Lauck Oil Company, Inc.

Josefiak #1

NW SW NE Sec. 10-20S-19W  
Pawnee County, KansasCommenced: July 17, 1961  
Completed: July 30, 1961Casing Record: 270' 10-3/4" Cemented with 220 sacks Cement and  
4 sacks Calcium Chloride.

Elevation: GR 2194; DF 2196; KB 2198.

## Drillers Log

## Tops

Clay	25'
Shale, Shells & Clay	120
Blue Shale	270
Grey Shale	305
Sand	450
Blue Shale	580
Red Bed	750
Sand	900
Red Bed	920
Sand	960
Red Bed	1200
Red Bed & Shale	1345
Anhydrite	1370
Red Bed & Shale	1450
Shale & Shells	2015
Shells & Shale	2185
Lime & Shale	2545
Lime	2635
Lime & Shale	3050
Shale & Lime	3295
Lime & Shale	3605
Lime	4061
Lime & Shale	4180
Shale & Clay	4195
Sand & Shale	4228
Conglomerate	4268
Shale & Chert	4290 RTD

	Sample
Heebner	3671-1473
Toronto	3692-1494
Douglas	3702-1504
Lansing	3721-1523
Base Kansas City	4038-1840
Marmaton	4045-1847
Cherokee Shale	4175-1977
Cherokee Sand	4187-1989
Conglomerate	4220-2022
Mississippian	4250-2052
Total Depth	4290-2092

DST #1 (S) 4166-4195, open one hour with strong blow thruout. Recovered 25' muddy water with a few heavy oil specks, 1375' of salt water.  
ISIP 1100#/20 min.  
FP 185#-690#

DST #2 (S) open one hour with strong blow thruout. Recovered 1280' of salt water.  
ISIP 1270#/30 min.  
FSIP 1220#/30 min.  
IFP 105#  
FFP 575#

D&amp;A.

RECEIVED  
STATE CORPORATION COMMISSION  
SEP 13 1961  
CONSERVATION DIVISION  
Wichita, Kansas