

"REVISED"

SIDE ONE

STATE CORPORATION COMMISSION OF KANSAS
OIL & GAS CONSERVATION DIVISION
WELL COMPLETION OR RECOMPLETION FORM
ACO-1 WELL HISTORY
DESCRIPTION OF WELL AND LEASE

Operator: License # 9971
Name Kodiak Petroleum, Inc.
Address 44 Inverness Drive East
Suite B, Building D
City/State/Zip Englewood, Colorado 80112

Purchaser Enron Gas Supply
Houston, Texas

Operator Contact Person Kent A. Johnson
Phone 303-790-7550

Contractor: License # 5302
Name Red Tiger Drilling Company

Wellsite Geologist Charles W. Cook
Phone 303-790-7550

Designate Type of Completion

X New Well Re-Entry Workover
Oil SWD Temp Abd
X Gas Inj Delayed Comp.
Dry Other (Core, Water Supply etc.)

If ONWO: old well info as follows:

Operator
Well Name
Comp. Date Old Total Depth

WELL HISTORY

Drilling Method:

X Mud Rotary Air Rotary Cable

11/3/87 11/11/87 12/24/87
Spud Date Date Reached TD Completion Date

4300! 2536!
Total Depth PBTD

Amount of Surface Pipe Set and Cemented at 452 feet
Multiple Stage Cementing Collar Used? Yes No
If yes, show depth set feet
If alternate 2 completion, cement circulated
from feet depth to w/ SX cmt
Cement Company Name PL Titano
Invoice #

API NO. 15-145-21,269-0000

County Pawnee

C. N1 NW1 SW1 Sec. 10 Twp 20S Rge 19 East
X West

2310 Ft North from Southeast Corner of Section
4620 Ft West from Southeast Corner of Section
(Note: Locate well in section plat below)


Lease Name Harms Well # 10-12

Field Name Oro Field (New Reservoir)

Producing Formation Chase

Elevation: Ground 2240 KB 2245

Section Plat

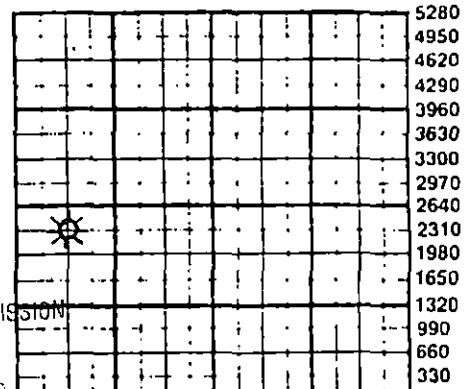

RECEIVED
STATE CORPORATION COMMISSION

JUN 23 1988

6-22-88

WATER SUPPLY INFORMATION

Disposition of Produced Water: Disposal
Docket # Repressuring

Questions on this portion of the ACO-1 call:
Water Resources Board (913) 296-3717

Source of Water:
Division of Water Resources Permit #

Groundwater Ft North from Southeast Corner
(Well) Ft West from Southeast Corner of
Sec Twp Rge East West

X Surface Water 4000 Ft North from Southeast Corner
(Stream, pond etc) 1400 Ft West from Southeast Corner
Sec 10 Twp 20 Rge 19 East X West

Other (explain) Anna Josefiak, Kinsley, KS 67547
(purchased from city, R.W.D. #)

INSTRUCTIONS: This form shall be completed in triplicate and filed with the Kansas Corporation Commission, 200 Colorado Derby Building, Wichita, Kansas 67202, within 120 days of the spud date of any well. Rule 82-3-130, 82-3-107 and 82-3-106 apply. Information on side two of this form will be held confidential for a period of 12 months if requested in writing and submitted with the form. See rule 82-3-107 for confidentiality in excess of 12 months. One copy of all wireline logs and drillers time log shall be attached with this form. Submit CP-4 form with all plugged wells. Submit CP-111 form with all temporarily abandoned wells.

All requirements of the statutes, rules and regulations promulgated to regulate the oil and gas industry have been fully complied with and the statements herein are complete and correct to the best of my knowledge.

Signature [Signature]

Title PRESIDENT Date June 20, 1988

Subscribed and sworn to before me this 20th day of June 1988

Notary Public Kris Ann Rosengren

Date Commission Expires My Commission Expires Sept. 18, 1988

K.C.C. OFFICE USE ONLY
F Letter of Confidentiality Attached
C Wireline Log Received
C Drillers Timelog Received
Distribution
KCC SWD/Rep NGPA
KGS Plug Other
(Specify)
6-22-88 X

Form ACO-1 (5-86)

Sec. 10 Twp 20S Rge 19E