

STATE OF KANSAS
STATE CORPORATION COMMISSION

Form CP-4

Give All Information Completely
Make Required Affidavit
Mail or Deliver Report to:
Conservation Division
State Corporation Commission
212 No. Market
Wichita, Kansas 67202

WELL PLUGGING RECORD

Pawnee County. Sec. 25 Twp. 20 Rge. (E) 19 (W)

Location as "NE/CNWSW" or footage from lines C W/2 SE SE

Lease Owner J. A. Allison

Lease Name Boyd Well No. 4

Office Address 1415 Wichita Plaza Bldg., Wichita, Ks.

Character of Well (completed as Oil, Gas or Dry Hole) oil

Date well completed May 5, 1970 19

Application for plugging filed July 14, 1972 19

Application for plugging approved July 17, 1972 19


Plugging commenced July 17, 1972 19

Plugging completed July 24, 1972 19

Reason for abandonment of well or producing formation unprofitable production

If a producing well is abandoned, date of last production October 31 1971

Was permission obtained from the Conservation Division or its agents before plugging was commenced? yes

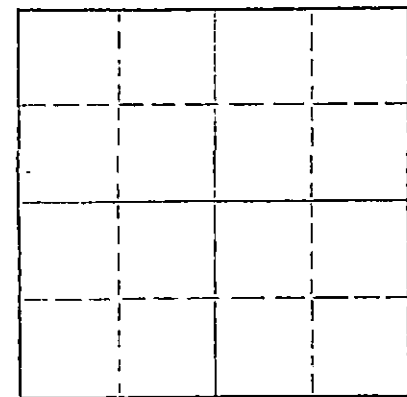

Locate well correctly on above Section Flat

Name of Conservation Agent who supervised plugging of this well Leo Massey

Producing formation Cherokee Sd Depth to top 4020 Bottom 4043 Total Depth of Well 4070 Feet

Show depth and thickness of all water, oil and gas formations.

OIL, GAS OR WATER RECORDS

CASING RECORD

FORMATION	CONTENT	FROM	TO	SIZE	PUT IN	PULLED OUT
Cherokee Sd	oil	4020	4043	8 5/8	@ 358	
				5 1/2	4069	2120

Describe in detail the manner in which the well was plugged, indicating where the mud fluid was placed and the method or methods used in introducing it into the hole. If cement or other plugs were used, state the character of same and depth placed, from _____ feet to _____ feet for each plug set.

Dig out cellar & deadman holes - rig up - sand back to 4030'.
pull slips - work pipe 20". Dump 5 sx cement - lead hole
with water - work pipe 21" - shoot & work pipe @ 2604, 2306,
& 2120. Pull 67 jts 5 1/2" pipe - total 2120' - tear down.
Pumped 5 sx hulls, 20 sx gel & 100 sx cement.

RECEIVED
STATE CORPORATION COMMISSION

AUG 31 1972

CONSERVATION DIVISION
Wichita, Kansas

(If additional description is necessary, use BACK of this sheet)

Name of Plugging Contractor Ralph Comstock

Address 320 N. Park, Stafford, Ks.

STATE OF KANSAS, COUNTY OF SEDGWICK, ss.

J. A. ALLISON (employee of owner) or (owner or operator) of the above-described

well, being first duly sworn on oath, says: That I have knowledge of the facts, statements, and matters herein contained and the log of the above-described well as filed and that the same are true and correct. So help me God.

(Signature) J. A. Allison

1415 Wichita Plaza Bldg., Wichita

(Address)

Subscribed and sworn to before me this 30 th day of August, 1972

January 14, 1974

Frances O. Erhard Notary Public.



B & B DRILLING, INC.
207 Petroleum Building
Wichita, Kansas 67202

MAY 8, 1970

RECEIVED
STATE CORPORATION COMMISSION
JAN 3 1972
CONSERVATION DIVISION
Wichita, Kansas

DRILLERS LOG

Re: Boyd #4
C W/2 SE SE Section 25-20-19W
Pawnee County, Kansas

OPERATOR: J. A. Allison
CONTRACTOR: B & B Drilling, Inc.
COMMENCED: Ma April 27, 1970
COMPLETED: May 5, 1970
TOTAL DEPTH: 4070'

Set 358' of 8 5/8" @/180 sx

0	358	Clay & Shale
358	509	Shale
509	1223	Shale & Sand
1223	1243	Anhydrite
1243	1825	Shale w/Lime
1825	2478	Shale & Lime
2478	3083	Lime & Shale
3083	3629	Lime & Shale
3629	3695	Lime
3695	3840	Lime
3840	4037	Lime
4037	4070	Coring
4070		Total Depth

Ran 5 1/2" casing @ 4069'w/10 Bbl
salt flush - 100 sx Regular cement.

We certify the above and foregoing to be true and correct copy of the log on the #4 Boyd, located in Pawnee County, Kansas.

Till Palmer President

Almond A. Kesser Notary Public
Subscribed and sworn to before me this 8th day
of May, 1970. My commission expires May 31, 1970