

STATE OF KANSAS
STATE CORPORATION COMMISSION

Form CP-4

Give All Information Completely
Make Required Affidavit
Mail or Deliver Report to:
Conservation Division
State Corporation Commission
212 No. Market
Wichita, Kansas

WELL PLUGGING RECORD

Pawnee County, Sec. 23 Twp. 20 Rge. 19 (E) (W)

Location as "NE/CNW&SW" or footage from lines C NW SW

Lease Owner Mull Drilling Company, Inc.

Lease Name Idker Well No. A-1

Office Address 1625 Wichita Plaza Building Wichita, Kansas

Character of Well (completed as Oil, Gas or Dry Hole) _____

Date well completed _____ 19____

Application for plugging filed 5-24-67 19____

Application for plugging approved 5-25-67 19____


Plugging commenced 5-27-67 19____

Plugging completed 6-9-67 19____

Reason for abandonment of well or producing formation _____

If a producing well is abandoned, date of last production _____ 19____

Was permission obtained from the Conservation Division or its agents before plugging was commenced? Yes

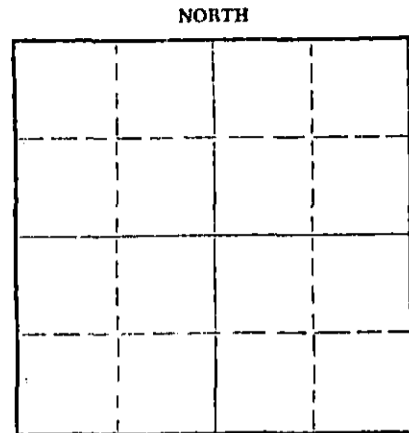

Locate well correctly on above Section Plat

Name of Conservation Agent who supervised plugging of this well Leo F. Massey

Producing formation _____ Depth to top _____ Bottom _____ Total Depth of Well 1329 Feet

Show depth and thickness of all water, oil and gas formations.

OIL, GAS OR WATER RECORDS

CASING RECORD

FORMATION	CONTENT	SIZE	PUT IN	PULLED OUT
		8 5/8	330	None
		4 1/2	None	3227

Describe in detail the manner in which the well was plugged, indicating where the mud fluid was placed and the method or methods used in introducing it into the hole. If cement or other plugs were used, state the character of same and depth placed, from _____ feet to _____ feet for each plug set.

Moved in. Cleaning out cellar. Working pipe.

Sanded to 1200'. Dumped 3 sacks of cement. Working pipe. Shot pipe at 3750' and 3631'.

Working pipe. Circulating. Globe Cementing spotted 70 bbl of oil.

Working pipe. Shot pipe at 3500' - 3400' - 3300' and 3220'.

Working pipe. Pulling pipe.

Bailed hole down. Pushed plug to 325' rock bridge. Dumped 8 sacks of cement.

Bailing hole dry. Dumped 19 sacks of cement. Filled hole and rock bridge. Capped well with 10 sacks of cement.

(If additional description is necessary, use BACK of this sheet)

Name of Plugging Contractor Forbes Casing Pulling, Inc.

Address P. O. Box 221 Great Bend, Kansas

STATE OF Kansas, COUNTY OF Barton, ss. J. O. Forbes (employee of owner) or (owner or operator) of the above-described well, being first duly sworn on oath, says: That I have knowledge of the facts, statements, and matters herein contained and the log of the above-described well as filed and that the same are true and correct. So help me God.

(Signature) J. O. Forbes
P. O. Box 221 Great Bend, Kansas
(Address)

SUBSCRIBED AND SWORN TO before me this 13 day of June, 19 67

My commission expires May 27, 1969

Notary Public.