

STATE OF KANSAS
STATE CORPORATION COMMISSION

WELL PLUGGING RECORD

Give All Information Completely
Make Required Affidavit
Mail or Deliver Report to
Conservation Division
State Corporation Comm.
245 North Water
Wichita, KS 67202

Pawnee County, Sec. 23 Twp. 20S Rge. 19W
Location as "NE/CNW/SW" or footage from lines
SW SW NW

Lease Owner Mull Drilling Company, Inc.
Lease Name HARMS SWDW Well No. #1

Office Address P.O. Box 2758, Wichita, KS 67201
Character of Well (Completed as Oil, Gas or Dry Hole)

Saltwater Disposal Well

Date Well completed 1/4

Application for plugging filed May 21st

Application for plugging approved May 22


Plugging commenced June 17

Plugging completed June 17

Reason for abandonment of well or producing formation

Noncommercial - Drilled Harms SWDW "Twin"

If a producing well is abandoned, date of last production

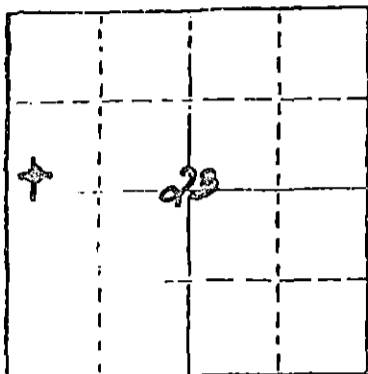

Locate well correctly on above
Section Plot

Was permission obtained from the Conservation Division or
its agents before plugging was commenced? Yes

Name of Conservation Agent who supervised plugging of this well Robert Tarbutton

Producing formation Cedar Hills Depth to top 780 Bottom 930 Total Depth of Well 998'

Show depth and thickness of all water, oil and gas formations.

OIL, GAS OR WATER RECORDS

CASING RECORD

FORMATION	CONTENT	FROM	TO	SIZE	PUT IN	PULLED OUT
				4 1/2"	997'	

Describe in detail the manner in which the well was plugged, indicating where the mud plug was placed and the method or methods used in introducing it into the hold. If cement or other plugs were used, state the character of same and depth placed, from _____ feet to _____ feet for each plug set.

6/17/85 Ran 700' 2-3/8" tbg. Plugged 4 1/2" as follows: 1 sac hulls, 140 sx 60-40 poz, 2% gel, 3% cc. Job by HOWCO. State plugging agent Robert Tarbutton
P&A 1:40 PM 6/17/85

(If additional description is necessary, use BACK of this sheet)

Name of Plugging Contractor MULL DRILLING COMPANY, INC. Operator #5144

STATE OF KANSAS COUNTY OF Sedgwick, ss.
Michael R. Kidwell (employee of owner) or (owner or operator)
of the above-described well, being first duly sworn on oath, says: That I have knowledge of the facts, statements, and matters herein contained and the log of the above-described well as filed and that the same are true and correct. So help me God.

(Signature) [Signature]
Michael R. Kidwell
P.O. Box 2758, Wichita 67201
(Address)

SUBSCRIBED AND SWORN TO before me this 18th day of June, 19 85



[Signature]
Notary Public.
Patricia L. Ungleich

My commission expires March 27, 1987

RECEIVED
STATE CORPORATION COMMISSION

JUL 20

CONSERVATION DIVISION
Wichita, Kansas

*filed with your
office
HARMS subW #1*

DRILLER'S LOG
on the
HARMS SALT WATER DISPOSAL WELL

0 - 60	clay
60 - 75	sand
75 - 90	shale
90 - 100	sand
100 - 110	shale
110 - 125	sand
125 - 140	shale
140 - 155	sand
155 - 175	shale
175 - 185	sand
185 - 200	shale
200 - 220	sand
220 - 275	shale
275 - 285	sand
285 - 310	shale
310 - 345	sand
345 - 375	shale
375 - 395	sandy shale
395 - 410	shale
410 - 440	sandy shale
440 - 460	shale
460 - 475	sand
475 - 490	shale
490 - 500	sand
500 - 525	shale
525 - 570	sandy shale
570 - 590	sand
590 - 650	shale
650 - 660	sand
660 - 685	shale
685 - 730	sandy shale
730 - 885	sand
885 - 900	shaley sand
900 - 935	sand
935 - 955	shale

Drilled By

SEIS-TECH EXPLORATION CO., INC.
331 Union Center
Wichita, Kansas

RECEIVED
STATE CORPORATE COMMISSION

MAY 22 1985
CONSULTANT DIVISION
Wichita, Kansas