

STATE OF KANSAS
STATE CORPORATION COMMISSION

WELL PLUGGING RECORD

Give All Information Completely
Make Required Affidavit
Mail or Deliver Report to:
Conservation Division
State Corporation Commission
211 No. Broadway
Wichita, Kansas

Pawnee County. Sec. 11 Twp. 20S Rge. (E) 19 (W)

Location as "NE/CNW/SW" or footage from lines C NW NE

Lease Owner Pickrell Drilling Company

Lease Name Spence Well No. 1

Office Address 705 4th National Bank Building, Wichita 2, Kansas

Character of Well (completed as Oil, Gas or Dry Hole) Dry Hole

Date well completed August 23, 19 65

Application for plugging filed August 23, 19 65

Application for plugging approved August 23, 19 65


Plugging commenced August 23, 19 65

Plugging completed August 23, 19 65

Reason for abandonment of well or producing formation Dry Hole

If a producing well is abandoned, date of last production 19

Was permission obtained from the Conservation Division or its agents before plugging was commenced? Yes

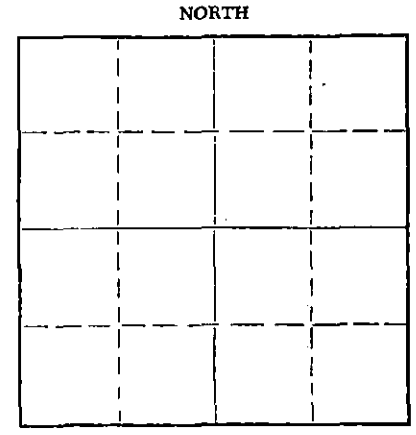

Name of Conservation Agent who supervised plugging of this well Eldon Petty, Hays, Kansas

Producing formation _____ Depth to top _____ Bottom _____ Total Depth of Well 4215 Feet

Show depth and thickness of all water, oil and gas formations.

OIL, GAS OR WATER RECORDS

CASING RECORD

FORMATION	CONTENT	FROM	TO	SIZE	PUT IN	PULLED OUT
				8 5/8"	421'	None

Describe in detail the manner in which the well was plugged, indicating where the mud fluid was placed and the method or methods used in introducing it into the hole. If cement or other plugs were used, state the character of same and depth placed, from _____ feet to _____ feet for each plug set.

Heavy mud to 550'. Set plug. Cemented with

20 sacks. Heavy mud to 40'. Set plug.

Cemented with 10 sacks cement to bottom of

cellar. Plugged rat hole with 2 sacks cement.

RECEIVED
STATE CORPORATION COMMISSION

AUG 27 1965

CONSERVATION DIVISION
Wichita, Kansas

(If additional description is necessary, use BACK of this sheet)

Name of Plugging Contractor Pickrell Drilling Company

Address 705 4th National Bank Bldg., Wichita, Kansas

STATE OF KANSAS, COUNTY OF SEDGWICK, ss.

C. W. SEBITS

~~(Signature of owner)~~ (owner or operator) of the above-described well, being first duly sworn on oath, says: That I have knowledge of the facts, statements, and matters herein contained and the log of the above-described well as filed and that the same are true and correct. So help me God.

(Signature) C. W. Sebits
705 4th National Bank Building, Wichita 2, Kansas
(Address)

SUBSCRIBED AND SWORN to before me this 26th day of August, 19 65

My commission expires October 13, 1968

Lorraine M. Johnson
Lorraine Johnson
Notary Public.

ROTARY DRILLING LOG

15.145.30024.0000

COMPANY: **PICKRELL DRILLING COMPANY**
 705 4th National Bank Bldg.
 Wichita, Kansas
 LOCATION: **C NW NE Sec. 11-20S-19W, Pawnee County, Kansas**
 Spence No. 1

Rotary Drilling Commenced 8-11-65
 Rotary Drilling Completed 8-23-65

CONTRACTOR: **PICKRELL DRILLING COMPANY**
 Wichita, Kansas

CASING RECORD: (19 jts.) 8 5/8" surface casing set at 421', cemented with 250 sacks cement. Circulated. Completed at 10:45 P.M. August 11, 1965. No oil string run. D & A

LOG

(Figures indicate bottom of formation — measurements from top of rotary bushing.)

	<u>C. F. S</u>
20 Soil & Clay	3638
25 Sand	3680
45 Post Rock	3720
310 Shale & Shells	3750
372 Sand	3790
422 Shale & Shells	3896
530 Shale	3847
775 Red Beds, Shale & Shells	3870
985 Sand	3880
1050 Red Beds	3900
1075 Sand	4112
1360 Shale & Shells	4117
1388 Anyhdrite	4122
1560 Shale & Shells	4135
1860 Shale	4142
1985 Shale & Shells	4163
2410 Shale & Lime	4173
2635 Lime	4183
3060 Shale & Lime	4193
3230 Shale	4215
3480 Shale & Lime	
3605 Shale with Lime Stringers	<u>Slope Tests</u>
3680 Lime & Shale	2500
3985 Lime	3000
4107 Lime & Shale	3500
4117 Sand	4000
4153 Lime & Chert	
4215 Arbuckle RTD	<u>S. L. M.</u>
	3402
	3648
	4011

RECEIVED
 STATE CORPORATION COMMISSION
 AUG 27 1965
 CONSERVATION DIVISION
 Wichita, Kansas

The undersigned, C. W. SEBITS, Attorney-in-Fact for PICKRELL DRILLING COMPANY, hereby certifies in behalf of said Company; that the above is a true and correct log of the formation encountered in drilling the above well as reflected by the Daily Drilling Reports.

PICKRELL DRILLING COMPANY
 By *C. W. Sebits*
C. W. SEBITS Attorney-in-Fact

STATE OF KANSAS }
 COUNTY OF SEDGWICK } ss.:

On this 26th day of August, 1965, before me the undersigned, a Notary Public, in and for the County and State aforesaid, personally appeared C. W. SEBITS, to me known to be the identical person who subscribed the name of PICKRELL DRILLING COMPANY to the foregoing instrument as its Attorney-in-Fact and acknowledged to me that he executed the same as his free and voluntary act and deed, and as the free and voluntary act and deed of such company, for the uses and purposes therein set forth.

Given under my hand and seal of office the day and year last above written.

My commission expires: October 13, 1968

Lorraine M. Johnson
 Lorraine Johnson Notary Public