

STATE OF KANSAS  
STATE CORPORATION COMMISSION

Give All Information Completely  
Make Required Affidavit  
Must be Delivered Report to  
Conservation Division  
State Corporation Commission

P. O. Box 17027  
Wichita, Kansas 67217  
NORTH

WELL PLUGGING RECORD

Pawnee County. Sec 18 Twp. 20 Rge. 19 (E) (W)  
Location as "NE/CNWESW" or footage from lines NW NE NW  
Lease Owner: National Cooperative Refinery Assn.  
Lessor Name Eckert Well No. 3  
Office Address Box 908 McPherson, Kansas  
Character of Well (completed as Oil, Gas or Dry Hole) \_\_\_\_\_  
Date well completed \_\_\_\_\_ 19\_\_\_\_  
Application for plugging filed 7/74 \_\_\_\_\_ 19\_\_\_\_  
Application for plugging approved 7/74 \_\_\_\_\_ 19\_\_\_\_  
Plugging commenced 7/16/74 \_\_\_\_\_ 19\_\_\_\_  
Plugging completed 7/29/74 \_\_\_\_\_ 19\_\_\_\_  
Reason for abandonment of well or producing formation \_\_\_\_\_  
If a producing well is abandoned, date of last production \_\_\_\_\_ 19\_\_\_\_  
Was permission obtained from the Conservation Division or its agents before plugging was commenced? Yes

	X		

Locate well correctly on above Section Plat

Name of Conservation Agent who supervised plugging of this well Leo Massey  
Producing formation \_\_\_\_\_ Depth to top \_\_\_\_\_ Bottom \_\_\_\_\_ Total Depth of Well \_\_\_\_\_ Feet  
Show depth and thickness of all water, oil and gas formations.

OIL, GAS OR WATER RECORDS

CASING RECORD

FORMATION	CONTENT	FROM	TO	SIZE	PUT IN	PULLED OUT
				8 5/8	455	None
				5 1/2	4330	2300

Describe in detail the manner in which the well was plugged, indicating where the mud fluid was placed and the method or methods used in introducing it into the hole. If cement or other plugs were used, state the character of same and depth placed, from \_\_\_\_\_ feet to \_\_\_\_\_ feet for each plug set.

7/16/74 Plug off Bottom - Dumped sand to 4000  
Mixed and dumped 5 sx. cement.  
7/29/74 Plug off Top - Allied Cementing Co.  
Mixed and pumped down 8 5/8" surface.  
Casing 20 sx. gel. - Plug - 50 sx. cement - 8 sx. gel. and  
20 sx. cement.

RECEIVED  
STATE CORPORATION COMMISSION  
AUG 22 1974  
CONSERVATION DIVISION  
Wichita, Kansas

(If additional description is necessary, use BACK of this sheet)  
Name of Plugging Contractor Russ Casing Pulling Inc.  
Address Box 1082 Great Bend, Kansas


STATE OF KANSAS COUNTY OF BARTON ss.  
Earl Baker Jr. (employee of owner) or (owner or operator) of the above-described  
well, being first duly sworn on oath, says: That I have knowledge of the facts, statements, and matters herein contained and the log of the  
above-described well as filed and that the same are true and correct. So help me God.

(Signature) Earl Baker Jr.  
Box 6, Great Bend, Kansas 67530  
(Address)

Subscribed and sworn to before me this 21st day of August, 1974

Patricia Bradley  
Patricia Bradley Notary Public.

My commission expires January 29, 1977

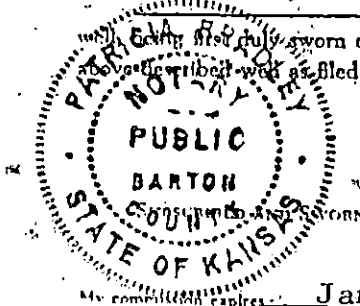

WELL LOG BUREAU—KANSAS GEOLOGICAL SOCIETY  
508 East Murdock, Wichita, Kansas


15.145.00742.0000

Company- NAT'L COOP. REFG. ASS'N.  
Farm- Eckert No. 3

SEC. 18 T.20 R.19W  
NW NE NW

Total Depth. 4331'  
Comm. 3-11-55 Comp. 3-26-55  
Shot or Treated.  
Contractor. Brinrich Drlg. Co., Inc.  
Issued. 5-21-55

County Pawnee  
KANSAS

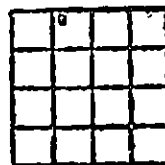

Elevation. 2261 KB

Production. 78 bbls./ NW

CASING:

8 5/8" 455'  
5 1/2" 4330'

Figures indicate Bottom of Formations.

surface soil	5
clay	30
shale-shells	125
shale-sand	280
shale-shells	305
sand	456
shale-shells	651
red bed-shale	835
sand	1049
red bed-shale	1309
Anhydrite	1426
red bed-shale	1505
shale-shells	1540
shale-salt	1895
shale	2140
shale-shells	2190
brkn lime	2260
shale	2370
lime-shale	2467
brkn lime	2580
lime	2650
lime-shale	2750
brkn lime	2830
lime	2915
shale-lime	3330
brkn lime	3460
lime-shale	3515
brkn lime	3612
lime-sand	3662
brkn lime	3760
lime	3815
lime-shale	3868
lime	3894
lime-shale strks	3975
lime	4008
lime-shale	4094
shale-sand	4240
lime-shale	4247
lime-shale-chert	
-sand	4265
lime-shale	4285
sand-shale	4300
lime-shale-chert	4331
Total Depth	

TOPS:

Anhydrite	1398
Heebner	3699
Toronto	3719
Lansing	3747
B/Kansas City	4084
Cherokee	4210
Sand	4227
Mississippi	4312

RECEIVED  
STATE CORPORATION COMMISSION  
JUN 18 1974  
CONSERVATION DIVISION  
Wichita, Kansas