


WELL PLUGGING RECORD

Give All Information Completely  
Make Required Affidavit  
Mail or Deliver Report to:  
Conservation Division  
State Corporation Commission  
800 Bitting House  
Wichita, Kansas

Pawnee County. Sec. 18 Twp. 20S Rge. 19 (W)  
Location as "NE/CNW%SW%" or footage from lines NW NE SW  
Lease Owner National Cooperative Refinery Association  
Lease Name SPRINGER Well No. 1  
Office Address 305 Rule Building, Wichita, Kansas  
Character of Well (completed as Oil, Gas or Dry Hole) Dry Hole  
Date well completed October 17 19 55  
Application for plugging filed October 18 19 55  
Application for plugging approved October 19 19 55  
Plugging commenced October 17 19 55  
Plugging completed October 17- 19 55  
Reason for abandonment of well or producing formation Dry Hole

NORTH

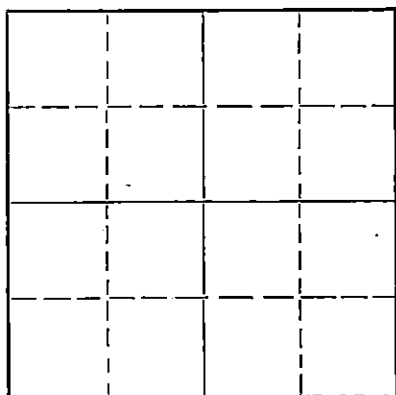

Locate well correctly on above  
Section Plat

If a producing well is abandoned, date of last production \_\_\_\_\_ 19\_\_\_\_  
Was permission obtained from the Conservation Division or its agents before plugging was commenced? Yes

Name of Conservation Agent who supervised plugging of this well Warren Horner  
Producing formation \_\_\_\_\_ Depth to top \_\_\_\_\_ Bottom \_\_\_\_\_ Total Depth of Well 4372 Feet  
Show depth and thickness of all water, oil and gas formations.

OIL, GAS OR WATER RECORDS

CASING RECORD

FORMATION	CONTENT	FROM	TO	SIZE	PUT IN	PULLED OUT
				8 5/8"	480'	None-Cemented

Describe in detail the manner in which the well was plugged, indicating where the mud fluid was placed and the method or methods used in introducing it into the hole. If cement or other plugs were used, state the character of same and depth placed, from \_\_\_\_\_ feet to \_\_\_\_\_ feet for each plug set.

Mudded hole to 300', set Halliburton plug / 1/3 sax hulls / 20 sax of cement.  
Mudded hole to 35', set Halliburton plug / 1/3 sax hulls / 10 sax of cement.  
Cemented filled on up to base of cellar.

RECEIVED  
STATE CORPORATION COMMISSION  
OCT 27 1955  
CONSERVATION DIVISION  
Wichita, Kansas

Name of Plugging Contractor M.B. Armer  
Address Petroleum Building, Wichita, Kansas

STATE OF Kansas, COUNTY OF Sedgwick, ss.  
C.R. Sears (employee of ~~owner~~) or (owner or operator) of the above-described

well, being first duly sworn on oath, says: That I have knowledge of the facts, statements and matters herein contained and the log of the above-described well as filed and that the same are true and correct. So help me God.

(Signature) C.R. Sears C.R. Sears

305 Rule Building, Wichita, Kansas  
(Address)

SUBSCRIBED AND SWORN to before me this 26th day of October, 19 55

C. Orville May  
C. ORVILLE MAY Notary Public.

My commission expires June 30, 1958

PLUGGING  
FILE SEC 127-20-R-196  
BOOK PAGE 9 LINE 25

Company: National Cooperative Refinery Association

Contractor: Strata Drilling, Inc.

Location: NW NE SW  
Section 18-20s-19w  
Pawnee County, Kansas

Farm Name: Springer #1

Commenced: October 2, 1955

Elevation:

Completed: October 17, 1955

Casing Used: 478' 6-5/8" surface csg.

0- 95	Surface soil & sand
115	Sand & shale
215	Sandy shale
405	Shale
430	Sand (Dakota)
473	Shale & shells
670	Shale & shells
870	Red bed
1020	Sand
1100	Red bed & shale
1115	Anhydrite
2270	Shale & shells
2695	Lime
2850	Lime & shale
2935	Lime
3105	Shale & lime
3215	Lime & shale
3295	Shale & lime
3465	Lime & shale
3935	Lime
3945	Shale & lime
4200	Lime
4265	Lime & shale
4290	Lime
4355	Lime & chat
4367	Lime
4367	Total depth

STATE OF KANSAS )  
                  ) ss.  
COUNTY OF BARTON)

I, the undersigned, being duly sworn on oath, state that the above statement and log are true and a correct record and log of the well drilled at the location above described.

STRATA DRILLING, INC.

*John V. Harlan*  
\_\_\_\_\_  
JOHN V. HARLAN, President

*Margaret J. Knapp*  
\_\_\_\_\_  
Notary Public

My commission expires February 11, 1959

RECEIVED  
STATE CORPORATION COMMISSION  
OCT 27 1955  
CONSERVATION DIVISION  
WELL LOGS

PLUGGING  
WELL SEC 18 T 20 R 19w  
DECK PAGE 2 LINE 25