


Give All Information Completely
Make Required Affidavit
Mail or Deliver Report to:
Conservation Division
State Corporation Commission
212 No. Market
Wichita, Kansas

WELL PLUGGING RECORD

Pawnee County, Sec. 8 Twp. 20S Rge. (E) 20 (W)

Location as "NE/CNWSW" or footage from lines NW NW
Lease Owner Beardmore Drilling Company
Lease Name MILLER "B" Well No. 1
Office Address 700 One Twenty Building-Wichita, Kansas
Character of Well (completed as Oil, Gas or Dry Hole) Dry Hole
Date well completed 7-2 19 68
Application for plugging filed 7-2 19 68
Application for plugging approved 7-2 19 68
Plugging commenced 7-2 19 68
Plugging completed 7-2 19 68
Reason for abandonment of well or producing formation No oil or gas found in commercial quantities.
If a producing well is abandoned, date of last production -- 19 --
Was permission obtained from the Conservation Division or its agents before plugging was commenced? Yes

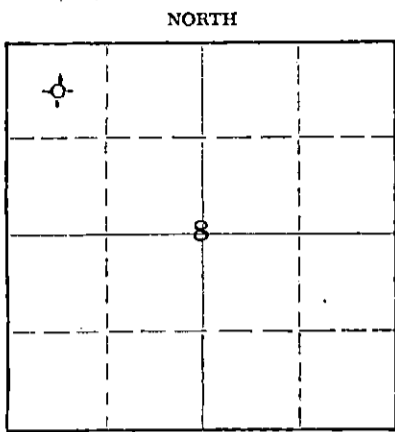

Locate well correctly on above Section Plat

Name of Conservation Agent who supervised plugging of this well Leo Massey, Hays, Kansas
Producing formation _____ Depth to top _____ Bottom _____ Total Depth of Well 4368 Feet
Show depth and thickness of all water, oil and gas formations.

OIL, GAS OR WATER RECORDS

CASING RECORD

FORMATION	CONTENT	FROM	TO	SIZE	PUT IN	PULLED OUT
				8-5/8"	319'	-0-

Describe in detail the manner in which the well was plugged, indicating where the mud fluid was placed and the method or methods used in introducing it into the hole. If cement or other plugs were used, state the character of same and depth placed, from _____ feet to _____ feet for each plug set.
Spotted 70 sacks 50-50 pozmix with 6% gel at 660'. Mud back to 300' and spotted 20 sacks same. Mud back to 40'. Set solid bridge and capped with 10 sacks. Plugging completed at 11:00 A.M. 7-2-68.

RECEIVED
STATE CORPORATION COMMISSION
JUL 12 1968
CONSERVATION DIVISION
Wichita, Kansas

(If additional description is necessary, use BACK of this sheet)
Name of Plugging Contractor Rains & Williamson Oil Co., Inc.
Address 1425 Wichita Plaza - Wichita, Kansas

STATE OF KANSAS, COUNTY OF SEDGWICK, ss.
Wilson Rains (employee of owner) or (owner or operator) of the above-described well, being first duly sworn on oath, says: That I have knowledge of the facts, statements, and matters herein contained and the log of the above-described well as filed and that the same are true and correct. So help me God.

(Signature) Wilson Rains Wilson Rains
1425 Wichita Plaza - Wichita, Kansas
(Address)

SUBSCRIBED AND SWORN TO before me this 9th day of July, 19 68

My commission expires June 30, 1971
Sherry Gish Notary Public.

15.145.20061.0000

ROTARY DRILLING LOG

Operator: Beardmore Drilling Company
MILLER "B" #1
NW NW Sec. 8-20S-20W
Pawnee County, Kansas

Contractor: Rains & Williamson
Oil Co., Inc.
Commenced: 6-26-68
Completed: 7-2-68 (Rotary)

Remarks: Set 8-5/8" surface casing at 319' w/ 200 sacks common w/ 2% CC.

Formations

Surface clay	40'
Shale & Post Rock	70'
Shale & Shells	363'
Shale	825'
Sand	1030'
Shale	1200'
Shale & Red Bed	1393'
Anhydrite	1422'
Shale	1580'
Shale & Lime Stks.	2212'
Lime & Shale	2975'
Shale & Lime	3730'
Lime	4358'
Lime & Chert	4368'
Rotary Total Depth (D & A)	4368'


RECEIVED
STATE CORPORATION COMMISSION
JUL 12 1968
CONSERVATION DIVISION
Wichita, Kansas

We certify the above log is true and correct to the best of our knowledge and belief.

RAINS & WILLIAMSON OIL CO., INC.


Wilson Rains Rotary Public

Subscribed and sworn to before me, a Notary Public within and for the State of Kansas, County of Sedgwick, this 9th day of July, 1968.

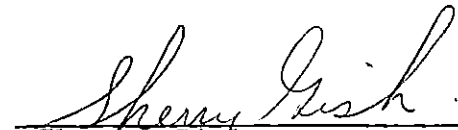
Sherry Gish

My commission expires:
June 30, 1971