


WELL PLUGGING RECORD

Give All Information Completely
Make Required Affidavit
Mail or Deliver Report to:
Conservation Division
State Corporation Commission
211 No. Broadway
Wichita, Kansas

Paumotu County. Sec. 23 Twp. 20 Rge. 17 (W) W (W)
Location as "NE/CNW/SW" or footage from lines C/SW SW NE
Lease Owner Leben Drilling, Inc.
Lease Name Seeman Well No. 1
Office Address Central Building, Wichita 2, Kansas
Character of Well (completed as Oil, Gas or Dry Hole) Dry hole
Date well completed 5-18 19 56
Application for plugging filed 5-18 19 56
Application for plugging approved 5-18 19 56
Plugging commenced 5-18 19 56
Plugging completed 5-18 19 56
Reason for abandonment of well or producing formation Dry hole, no commercial oil or gas shows
If a producing well is abandoned, date of last production _____ 19____
Was permission obtained from the Conservation Division or its agents before plugging was commenced? Yes

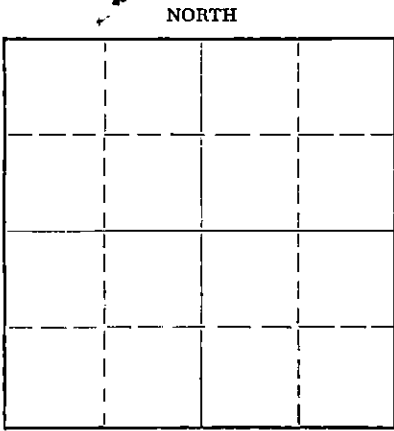

Locate well correctly on above Section Plat

Name of Conservation Agent who supervised plugging of this well R. M. Brundage
Producing formation _____ Depth to top _____ Bottom _____ Total Depth of Well 3970 Feet
Show depth and thickness of all water, oil and gas formations.

OIL, GAS OR WATER RECORDS

CASING RECORD

FORMATION	CONTENT	FROM	TO	SIZE	PUT IN	PULLED OUT

Describe in detail the manner in which the well was plugged, indicating where the mud fluid was placed and the method or methods used in introducing it into the hole. If cement or other plugs were used, state the character of same and depth placed, from _____ feet to _____ feet for each plug set.

Mud level 305', placed 1/3 sack of Hulls at 305', placed Halliburton plug on top of Hulls and cemented through drill pipe with 25 sacks cement. Placed top plug at 30' with 10 sacks cement.

(If additional description is necessary, use BACK of this sheet)

Name of Plugging Contractor Kan-Tex Drillers, Inc.
Address 413 Beacon Building, Wichita 2, Kansas

STATE OF Kansas, COUNTY OF Sedgwick, ss.
Harvey E. Nightingale contractor (employee of owner) or (owner or operator) of the above-described well, being first duly sworn on oath, says: That I have knowledge of the facts, statements, and matters herein contained and the log of the above-described well as filed and that the same are true and correct. So help me God.

(Signature) Harvey E. Nightingale
Wichita, Kansas (Address)

SUBSCRIBED AND SWORN TO before me this 22nd day of May, 1956

My commission expires Dec. 27, 1959

Barbara Laramore
Notary Public.

PLUGGING
FILE SEC 23 T. 20 R. 17 W
BOOK PAGE 62 LINE 22

RECEIVED
STATE CORPORATION COMMISSION
Wichita, Kansas
5-23-1956

DRILLERS' LOG

No. 1 Seeman
SW SW NE Section 23-20S-17W
Pawnee County, Kansas

FROM	TO	
0	510	Shale and sand
510	640	Sand
640	1060	Sand and shale
1060	1105	Sand, shale, shells
1105	1140	Anhydrite
1140	1405	Shale, anhy., shells
1405	1690	Red bed and shale
1690	1760	Salt and shale
1760	1950	Shale and shells
1950	2092	Lime
2092	2243	Lime and shale
2243	2552	Lime
2552	2636	Lime and shale
2636	2817	Shale and shells
2817	2942	Shale and lime
2942	3509	Lime and shale
3509	3718	Lime
3718	3783	Lime and shale
3783	3854	Lime
3854	3889	Conglomerate
3889	3900	Cherty lime
3900	3938	Cong. and lime
3938	3970	Lime
	3970	Rotary total depth D & A

COMMENCED: 5-5-1956

COMPLETED: 5-18-1956

CASING RECORD:

Set 8 5/8" surface casing
at 296' with 250 sacks
cement, 2% Calcium chloride.

STATE OF KANSAS)
) S S
COUNTY OF SEDGWICK)

I hereby affirm that the above and foregoing is a true and correct copy of the formations encountered on the No. 1 Seeman, SW SW NE Section 23-20S-17W, Pawnee County, Kansas, as reflected by the daily drilling reports.

KAN-TEX DRILLERS, INC.

By: *Harvey E. Nightingale*
Harvey E. Nightingale

Subscribed and sworn to before me this 21st day of May, 1956

My Commission Expires: 12-27-59

Barbara Larimore
Notary Public

RECEIVED
STATE CORPORATION COMMISSION

MAY 23 1956

CONSERVATION DIVISION
Wichita, Kansas

PLUGGING
FILE SEC. 23 T. 20 R. 17W
BOOK PAGE 62 LINE 22