


STATE OF KANSAS  
STATE CORPORATION COMMISSION  
200 Colorado Derby Bldg.  
Wichita, Kansas 67202

WELL PLUGGING RECORD

Give All Information Completely  
Make Required Affidavit

COUNTY Pawnee SEC. 20 TWP. 20 RGE. 17 E7W  
Location as in quarters or footage from lines:

C SE/4

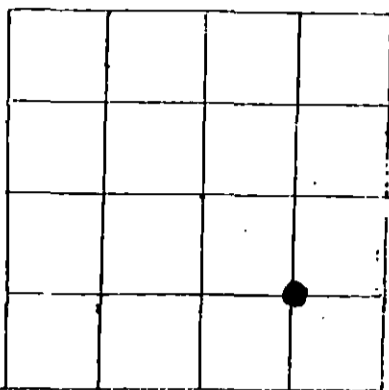

Locate Well  
correctly on above  
Section Platt.

Lease Owner Anador Resources, Inc.  
Lease Name Haas Well No. 1-20  
Office Address 5700 S. Quebec Suite 320 Englewood, Colorado 80111  
Character of Well (Completed as Oil, Gas or Dry Hole): Dry  
Date Well Completed 7-12-82  
Application for plugging filed 6-8-82  
Plugging commenced 7-12-82  
Plugging completed 7-12-82  
Reason for abandonment of well or producing formation

Dry Hole

Was permission obtained from the Conservation Division or it's  
Agent's before plugging was commenced? Yes

Name of Conservation Agent who supervised plugging of this well Steve Durrant  
Producing formation \_\_\_\_\_ Depth to top \_\_\_\_\_ bottom T.D. 2232'

Show depth and thickness of all water, oil and gas formations.

OIL, GAS OR WATER RECORDS

Casing Record

Formation	Content	From	To	Size	Put in	Pulled Out
<u>Krider</u>	<u>Water</u>	<u>2072</u>	<u>2106</u>	<u>7"</u>	<u>1020</u>	<u>NONE</u>
<u>Winfield</u>	<u>Water</u>	<u>2128</u>	<u>2150</u>	<u>4 1/2"</u>	<u>2232</u>	<u>NONE</u>
<u>Towanda</u>	<u>Water</u>	<u>2189</u>	<u>2218</u>			

Describe in detail the manner in which the well was plugged, indicating where the mud  
fluid was placed and the method or methods used in introducing it into the hold. If cement  
or other plugs were used, state the character of same and depth placed, from \_\_\_\_\_ feet  
to \_\_\_\_\_ feet for each plug set.

Mixed 2 sxs. hulls, 7 sxs. of gel, followed by 70 sxs. 50-50 POZ w/4% gel & 3% CaCl.  
Pressured to 2000 PSIG and shut in. Pumped 15 sxs. 50-50 POZ w/4% gel & 3% CaCl  
down 4 1/2" - 7" annulus. Pressured to 500 PSIG and shut in.

RECEIVED  
STATE CORPORATION COMMISSION

AUG 02 1982

CONSERVATION DIVISION  
Wichita, Kansas

(If additional description is necessary; use BACK of this sheet)

Name of Plugging Contractor Sun Cementers, Great Bend, Kansas

STATE OF Colorado COUNTY OF Arapahoe, ss.

David S. Dudzik (employee of owner) or (~~owner or operator~~) of the  
above-described well, being first duly sworn on oath, says: That I have knowledge of the  
facts, statements, and matters herein contained and the log of the above-described well as  
filed and that the same are true and correct. So help me God.

(Signature) David S. Dudzik  
David S. Dudzik  
(Address)

SUBSCRIBED AND SWORN TO before me this 28th day of July, 19 82 CO 80111

Constance A. Lowe  
Constance A. Lowe Notary Public.

My Commission expires: 01/29/84