


STATE OF KANSAS
STATE CORPORATION COMMISSION

WELL PLUGGING RECORD

Give All Information Completely
Make Required Affidavit
Mail or Deliver Report to:
Conservation Division
State Corporation Commission
800 Bitting Building
Wichita, Kansas

NORTH

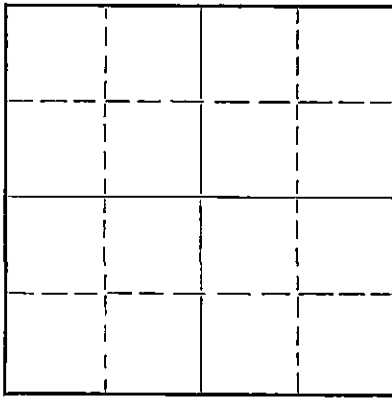

Locate well correctly on above
Section Flat

Pawnee County. Sec. 16 Twp. 20 Rge. 17 (E) (W)
Location as "NE/CNW $\frac{1}{4}$ SW $\frac{1}{4}$ " or footage from lines SW $\frac{1}{4}$ SW $\frac{1}{4}$ SE $\frac{1}{4}$
Lease Owner The El Dorado Refining Co.
Lease Name Behrens #1 Well No. 1
Office Address El Dorado, Ks. (407 Brown Bldg., Wichita, Ks.)
Character of Well (completed as Oil, Gas or Dry Hole) Dry Hole
Date well completed November 9 19 50
Application for plugging filed November 9 19 50
Application for plugging approved November 9 19 50
Plugging commenced November 9 19 50
Plugging completed November 9 19 50
Reason for abandonment of well or producing formation Dry Hole

If a producing well is abandoned, date of last production 19
Was permission obtained from the Conservation Division or its agents before plugging was commenced? Yes

Name of Conservation Agent who supervised plugging of this well C. D. Stough
Producing formation Depth to top Bottom Total Depth of Well 399h Feet
Show depth and thickness of all water, oil and gas formations.

OIL, GAS OR WATER RECORDS

CASING RECORD

Formation	Content	From	To	Size	Put In	Pulled Out
				8-5/8"	1178'	

Describe in detail the manner in which the well was plugged, indicating where the mud fluid was placed and the method or methods used in introducing it into the hole. If cement or other plugs were used, state the character of same and depth placed, from feet to feet for each plug set.

Filled with heavy mud to 250'. Set plug.
Ran 15 sacks cement through drill pipe.
Filled with heavy mud to 30' of surface.
Set plug. Ran 10 sacks cement.

RECEIVED
STATE CORPORATION COMMISSION
NOV 16 1950
CONSERVATION DIVISION
WICHITA, KANSAS

(If additional description is necessary, use BACK of this sheet)

Correspondence regarding this well should be addressed to Sterling Drilling Company
Address Sterling, Kansas

STATE OF Kansas, COUNTY OF Rice, ss.
Rollin Mead (employee of owner) or (owner or operator) of the above-described well,
being first duly sworn on oath, says: That I have knowledge of the facts, statements, and matters herein contained and the log of the above-described well as filed and that the same are true and correct. So help me God.

(Signature) Rollin Mead
Sterling, Kansas
(Address)

SUBSCRIBED AND SWORN to before me this 10th day of November, 19 50

My commission expires 9-17-52

Notary Public

PLUGGING
FILE SEC-46-T-10-R-17
BOOK PAGE 42 LINE 15

STERLING DRILLING CO.

STERLING, KANSAS

Well Log - - - - - Behrens #1

Location - C SW/4 SW/4 SE/4 of Section 16-20S-17W, Pawnee County, Ks.

Owner - The El Dorado Refining Company
 Contractor - Sterling Drilling Company

Commenced - 10-23-50
 Completed - 11-10-50 (w/r)

Total Depth - 3994' (w/r)

LOG

0- 20	Surface Soil
20- 110	Shale and Sand Strks
110- 150	Lime, Shells, Shale and Sand
150- 380	Shale and Shells
380- 515	Shale and Red Bed
515- 675	Sand
675- 790	Shale, Shells, Sand Strks
790- 910	Shale and Shells
910-1162	Red Bed and Shells
1162-1178	Anhydrite
1178-1610	Shale and Red Bed
1610-1670	Shale and Red Bed
1670-1890	Salt and Shale
1890-2280	Shale and Lime
2280-2550	Lime
2550-2860	Lime and Shale
2860-2890	Shale
2890-3005	Shale and Lime Strks
3005-3075	Lime
3075-3435	Lime and Shale
3435-3535	Lime
3535-3550	Broken Lime
3550-3665	Lime
3665-3690	Lime and Shale
3690-3760	Lime
3760-3805	Lime and Shale Brks
3805-3850	Lime
3850-3880	Shale
3880-3913	Shale and Lime Strks
3913-3933	Conglomerate
3933-3940	Arbuckle Lime
3940-3994	Lime

CASING RECORD

1178' of 8-5/8" Surface Pipe
 Cemented with 500 Sacks Cement

RECEIVED
 STATE CORPORATION COMMISSION
 NOV 16 1950
 CONSERVATION DIVISION
 Wichita, Kansas

PLUGGING
 FILE SEC 16-20-17W
 BOOK PAGE 42 LINE 15