


STATE OF KANSAS
STATE CORPORATION COMMISSION

15.145.20549.0000

WELL PLUGGING RECORD

Give All Information Completely
Make Required Affidavit
Mail or Deliver Report to
Conservation Division
State Corporation Comm.
245 North Water
Wichita, KS 67202

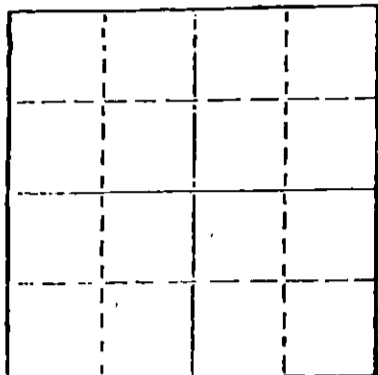

Locate well correctly on above Section Plot

Pawnee County, Sec. 14 Twp. 20S Rge. 17W E/W
Location as "NE/CNW $\frac{1}{2}$ SW $\frac{1}{4}$ " or footage from lines C SE SE

Lease Owner Sanders Oil Company Inc.
Lease Name Seeman Well No. 1
Office Address 910 Sutton Place Wichita, Ks. 67202
Character of Well (Completed as Oil, Gas or Dry Hole)
Dry Hole

Date Well completed 12-8-78 1978
Application for plugging filed 12-7 1978
Application for plugging approved 12-7 1978
Plugging commenced 12-8 1978
Plugging completed 12-8 1978

Reason for abandonment of well or producing formation
dry hole
If a producing well is abandoned, date of last production 19

Was permission obtained from the Conservation Division or its agents before plugging was commenced? Yes

Name of Conservation Agent who supervised plugging of this well Leo Massey
Producing formation _____ Depth to top _____ Bottom _____ Total Depth of Well 3920'
Show depth and thickness of all water, oil and gas formations.

OIL, GAS OR WATER RECORDS

CASING RECORD

FORMATION	CONTENT	FROM	TO	SIZE	PUT IN	PULLED OUT

Describe in detail the manner in which the well was plugged, indicating where the mud fluid was placed and the method or methods used in introducing it into the hold. If cement or other plugs were used, state the character of same and depth placed, from _____ feet to _____ feet for each plug set.

Bottom set @ 480' w/50 sacks 50/50 pozmix, 2% gel through drill pipe.
Middle plug set @ 300' w/20 Sacks 50/50 Pozmix through drill pipe.
Top Plug Set @ 40' w/ $\frac{1}{2}$ sack hulls & 10 sacks cement.
2 sacks cement down the rat hole.

RECEIVED
STATE CORPORATION COMMISSION

DEC 12 1978

CONSERVATION DIVISION
Wichita, Kansas

(If additional description is necessary, use BACK of this sheet)

Name of Plugging Contractor Duke Drilling Co., Inc.

STATE OF Kansas COUNTY OF Barton, ss.
Bill Draney (employee of owner) or (owner or operator)
of the above-described well, being first duly sworn on oath, says: That I have knowledge of the facts, statements, and matters herein contained and the log of the above-described well as filed and that the same are true and correct. So help me God.

(Signature) Bill Draney
Box 823 Great Bend, KS 67530
(Address)

SUBSCRIBED AND SWORN TO before me this 11th day of December, 1978

Deborah M. Haque
Notary Public.

My commission expires 4-11-1982

15.145.20549.0000

DRILLERS' WELL LOG

DATE COMMENCED: November 28, 1978
DATE COMPLETED: December 6, 1978

Sanders Oil Co., Inc.
SEEMAN #1
C SE SE
Sec. 14-20S-17W
Pawnee County, Kansas

0	-	100'	Clay & Shale
100	-	500'	Shale
500	-	655'	Sand
655	-	930'	Red Bed
930	-	1101'	Shale
1101	-	1132'	Anhydrite
1132	-	1690'	Shale
1690	-	2373'	Shale & Lime
2373	-	3156'	Lime & Shale
3156	-	3425'	Lime
3425	-	3430'	Shale
3430	-	3436'	Lime & Shale
3436	-	3455'	Shale
3455	-	3494'	Shale & Lime
3494	-	3768'	Lime
3768	-	3865'	Lime, Shale, Chert
3865	-	3920'	Dolomite
		3920'	RTD

ELEVATION: 2064 K.B.

<u>FORMATION DATA</u>	
Anhydrite	1101'
Topeka	3156'
Heebner	3425'
Toronto	3436'
Douglas	3455'
Lansing KC	3494'
Base KC	3768'
Marmaton	3776'
Conglomerate	3865'
Arzuckle	3865'
RTD	3920'

SURFACE PIPE: Set new 6-5/8" 24# pipe @ 337' & cemented w/175 sacks 60/40 pozmix, 2 1/2 gal, 3 1/2 cc.

A F F I D A V I T

STATE OF KANSAS
COUNTY OF BARTON) ss.

Bill Draney, of lawful age does swear and state that the facts and statements herein contained are true and correct to the best of his knowledge.

Bill Draney

Subscribed and sworn to before me this 11th day of December, 1978.

My Comm. Expires:
April 11, 1982

Dorothy M. Hague
Notary Public

RECEIVED
STATE CORPORATION COMMISSION

DEC 12 1978

CONSERVATION DIVISION
Wichita, Kansas