


WELL PLUGGING RECORD

Give All Information Completely
Make Required Affidavit
Mail or Deliver Report to:
Conservation Division
State Corporation Commission
800 Bittling Building
Wichita, Kansas

NORTH

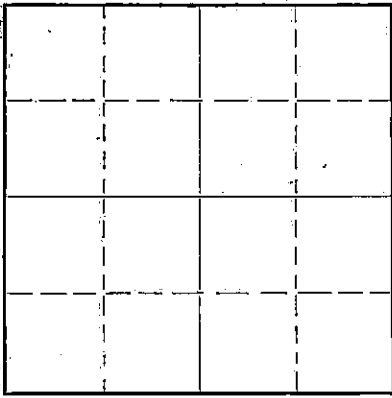

Locate well correctly on above
Section Flat

Pawnee County. Sec. 11 Twp. 20S. Rge. 17. ~~W.~~ N. (W)
Location as "NE/CNW $\frac{1}{4}$ SW $\frac{1}{4}$ " or footage from lines NW NW SW
Lease Owner Jayhawk Drlg. Co., Inc., & Vickers Petroleum Co., Inc.
Lease Name Seeman Well No. 1
Office Address 201 W-K-H Bldg., Wichita, Kansas
Character of Well (completed as Oil, Gas or Dry Hole) Dry
Date well completed October 12 19 49
Application for plugging filed October 12 19 49
Application for plugging approved October 12 19 49
Plugging commenced October 12 19 49
Plugging completed October 13 19 49
Reason for abandonment of well or producing formation Dry

If a producing well is abandoned, date of last production 19
Was permission obtained from the Conservation Division or its agents before plugging was commenced? yes

Name of Conservation Agent who supervised plugging of this well C. D. Stough, Great Bend, Kansas
Producing formation Arbuckle Depth to top 3936 Bottom 3966 Total Depth of Well 3966 Feet
Show depth and thickness of all water, oil and gas formations.

OIL, GAS OR WATER RECORDS

CASING RECORD

Formation	Content	From	To	Size	Put In	Pulled Out
				8-5/8"	1156'	None

Describe in detail the manner in which the well was plugged, indicating where the mud fluid was placed and the method or methods used in introducing it into the hole. If cement or other plugs were used, state the character of same and depth placed, from _____ feet to _____ feet for each plug set.

Filled hole with mud, set plug @ 250'. Dump 15 sx cement. Filled w/mud to 30'. Set plug and capped with 10 sx cement.

10-15-1949
OCT 15 1949
KANSAS

(If additional description is necessary, use BACK of this sheet)

Correspondence regarding this well should be addressed to The Vickers Petroleum Co., Inc.
Address 201 W-K-H Building, Wichita, Kansas

STATE OF Kansas, COUNTY OF Sedgwick, ss.
John M. Little (employee of owner) or (owner or operator) of the above-described well,
being first duly sworn on oath, says: That I have knowledge of the facts, statements, and matters herein contained and the log of the above-described well as filed and that the same are true and correct. So help me God.

(Signature) John M. Little
(Address) _____

SUBSCRIBED AND SWORN to before me this 12 th day of October 19 49.

Allen J. Denton
Notary Public.

My commission expires August 13, 1953

PLUGGING
FILE SEC 11 T 20 R 17W
BOOK PAGE 119 LINE 30

THE JAYHAWK DRILLING CO., INC., and THE VICKERS PETROLEUM CO., INC.

Seaman Well #1
NW. NW. SW. Sec. 11-203-17W
Pawnee County, Kansas

Casing Record:
8-5/8" @ 1156' w/500 ex

Commenced: September 28, 1949
Completed: October 12, 1949

Elevation: 2094 R.B.
Potential: D & A

L O G

Shale & Shells	0-540
Sand	540-770
Shale & Shells	770-1080
Red Bed & Shale	1080-1158
Anhydrite	1158-1179
Red Bed Shale & Shells	1179-1365
Shells & Shale	1365-1600
Salt & Shale	1600-1675
Shale & Salt	1675-1790
Lime & Shale	1790-2195
Broken Lime & Sand	2195-2290
Lime Broken	2290-2325
Lime	2325-2420
Lime & Shale	2420-2940
Shale & Lime	2940-3190
Lime & Shale	3190-3220
Lime	3220-3390
Lime & Shale	3390-3420
Lime	3420-3490
Shale	3490-3558
Lime	3558-3811
Shale, Lime, Chert	3811-3911
Conglomerate	3911-3936
Dolomite	3936-3966 R.T.D.

D & A

Tops:	
Heebner	3490
Lansing	3558
Base Kan. City	3811
Conglomerate	3911
Arbuckle	3936

I hereby certify that this log is true and correct to the best of my knowledge and belief.

THE VICKERS PETROLEUM CO., INC.
THE JAYHAWK DRILLING CO., INC.

By *A. L. Davis*

Sworn and subscribed to before me
this 14 day of October, 1949.

Allen J. Denton
Notary Public

My commission expires Aug. 13, 1953.

RECORDED
OCT 15 1949
STATE CORPORATION
COMMISSION
KANSAS

PLUGGING
FILE SECT T 20 R 174
BOOK PAGE 119 LINE 30