


STATE OF KANSAS
STATE CORPORATION COMMISSION

WELL PLUGGING RECORD

Give All Information Completely
Make Required Affidavit
Mail or Deliver Report to:
Conservation Division
State Corporation Commission
211 No. Broadway
Wichita, Kansas

Pawnee County, Sec. 29 Twp. 20S Rge. 18W XE (W)
Location as "NE/CNW%SW%" or footage from lines NW NW NE
Lease Owner Rock Island Oil & Refining Co., Inc.
Lease Name Fox Well No. 1
Office Address 321 West Douglas, Wichita, Kansas
Character of Well (completed as Oil, Gas or Dry Hole) Dry Hole
Date well completed 8-19-67 19
Application for plugging filed 8-19-67 19
Application for plugging approved 8-19-67 19
Plugging commenced 8-19-67 19
Plugging completed 8-19-67 19
Reason for abandonment of well or producing formation Dry Hole

NORTH

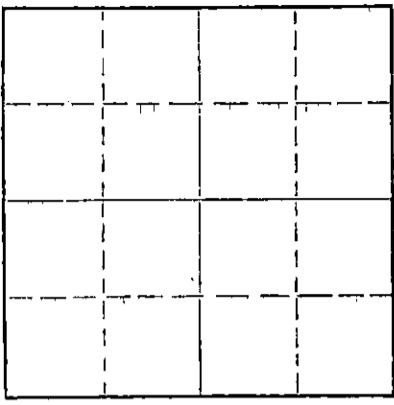

Locate well correctly on above Section Plat

If a producing well is abandoned, date of last production _____ 19____
Was permission obtained from the Conservation Division or its agents before plugging was commenced? yes

Name of Conservation Agent who supervised plugging of this well Leo Massey
Producing formation _____ Depth to top _____ Bottom _____ Total Depth of Well 4110 Feet
Show depth and thickness of all water, oil and gas formations.

OIL, GAS OR WATER RECORDS

CASING RECORD

FORMATION	CONTENT	FROM	TO	SIZE	PUT IN	PULLED OUT
				8 5/8"	263'	none

Describe in detail the manner in which the well was plugged, indicating where the mud fluid was placed and the method or methods used in introducing it into the hole. If cement or other plugs were used, state the character of same and depth placed, from _____ feet to _____ feet for each plug set.

Spotted with 100 sacks Posmix with 6% gel @ 600'
Spotted with 25 sks. Posmix with 6% gel @ 250'
& put 10 sks. cement on top of bridge @ 40'

RECEIVED
STATE CORPORATION COMMISSION

AUG 23 1967

CONSERVATION DIVISION
Wichita, Kansas

(If additional description is necessary, use BACK of this sheet)

Name of Plugging Contractor Leben Drilling, Inc.
Address Box 486, Great Bend, Kansas 67530

STATE OF KANSAS, COUNTY OF BARTON, ss.
Leslie Kite (employee of owner) or (owner or operator) of the above-described well, being first duly sworn on oath, says: That I have knowledge of the facts, statements, and matters herein contained and the log of the above-described well as filed and that the same are true and correct. So help me God.

(Signature) Leslie Kite
Box 486, Great Bend, Kansas 67530
(Address)

SUBSCRIBED AND SWORN TO before me this 22nd day of August, 1967.

Ulanda Nichols
Notary Public.

My commission expires April 1, 1971

DRILLER'S LOG

COMPANY: Rock Island Oil & Refining Co., Inc.
 CONTRACTOR: LEBEN DRILLING, INC.
 FARM: FOX #1
 LOCATION: NW NW NE SECTION 29-20S-18W
 PAWNEE COUNTY, KANSAS
 COMMENCED: 8-9-67
 COMPLETED: 8-19-67

0	263	Shale
263	395	Shale, Redbed
395	710	Shale
710	800	Sand
800	1130	Redbed
1130	1254	Redbed, Shale
1254	1415	Anhydrite
1415	1930	Shale, Lime
1930	2665	Lime
2665	2995	Lime, Shale
2995	3100	Shale, Lime
3100	3616	Lime, Shale
3616	4110	Lime
	<u>4110</u>	<u>RTD - D. & A.</u>

RECEIVED
 STATE CORPORATION COMMISSION
 AUG 23 1967
 CONSERVATION DIVISION
 Wichita, Kansas

8 5/8" used 28# surface casing set @ 263' cemented with 175 sacks
 Common, 2% cc

I, Leslie Kite, do hereby certify that the above and foregoing is a true and correct copy of the log of the Fox #1 Well, located NW NW NE of Section 29, Township 20 South, Range 18 West, Pawnee County, Kansas, as reflected by the records of Leben Drilling, Inc.

Leslie Kite
 Leslie Kite

STATE OF KANSAS)
) SS
 COUNTY OF BARTON)

Subscribed and sworn to and before me, a Notary Public, in and for Barton County, Kansas, this 22nd day of August, 1967.

Ulanda Nichols
 Ulanda Nichols

My Commission Expires:
 April 1, 1971