


STATE OF KANSAS  
STATE CORPORATION COMMISSION

WELL PLUGGING RECORD

Give All Information Completely  
Make Required Affidavit  
Mail or Deliver Report to:  
Conservation Division  
State Corporation Commission  
800 Bitting Building  
Wichita, Kansas

Pawnee County. Sec. 7 Twp. 20 Rge. (E) 19 (W)  
Location as "NE/CNW/SW" or footage from lines 990' ENL & 400' FWL NW/4  
Lease Owner TexKan Oil Company  
Lease Name CARR Well No. 1  
Office Address 518 Petroleum Building, Wichita, Kansas.  
Character of Well (completed as Oil, Gas or Dry Hole) Dry Hole  
Date well completed March 24, 1954  
Application for plugging filed verbally March 23, 1954  
Application for plugging approved verbally March 23, 1954  
Plugging commenced March 24, 1954  
Plugging completed March 24, 1954  
Reason for abandonment of well or producing formation Dry Hole

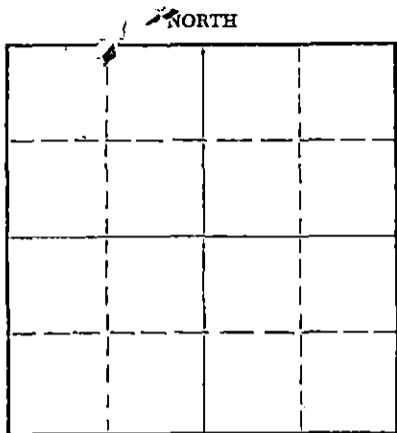

Locate well correctly on above  
Section Plat

If a producing well is abandoned, date of last production 19  
Was permission obtained from the Conservation Division or its agents before plugging was commenced? verbally

Name of Conservation Agent who supervised plugging of this well \_\_\_\_\_  
Producing formation \_\_\_\_\_ Depth to top \_\_\_\_\_ Bottom \_\_\_\_\_ Total Depth of Well 4310 Feet  
Show depth and thickness of all water, oil and gas formations.

OIL, GAS OR WATER RECORDS

CASING RECORD

FORMATION	CONTENT	FROM	TO	SIZE	PUT IN	PULLED OUT
				8-5/8"	330'	

Describe in detail the manner in which the well was plugged, indicating where the mud fluid was placed and the method or methods used in introducing it into the hole. If cement or other plugs were used, state the character of same and depth placed, from \_\_\_\_\_ feet to \_\_\_\_\_ feet for each plug set.

Filled hole with heavy mud to 300'.  
Set first plug at 300' with 20 sacks cement.  
Set second plug at 40' with 10 sacks cement.

(If additional description is necessary, use BACK of this sheet)  
Name of Plugging Contractor Musgrove Petroleum Corporation,  
Address 518 Petroleum Building, Wichita, Kansas.

STATE OF Kansas COUNTY OF Sedgwick  
I, Gordon L. Koelling (employee of owner) or (owner or operator) of the above-described well, being first duly sworn on oath, says: That I have knowledge of the facts, statements, and matters herein contained and the log of the above-described well as filed and that the same are true and correct. So help me God.

(Signature) Gordon L. Koelling  
518 Petroleum Building, Wichita, Kansas.  
(Address)

SUBSCRIBED AND SWORN TO before me this 29th day of March, 19 54

My commission expires July 16, 1955

Alma E. Rose  
Notary Public.

PLUGGING  
WELL SEC 7 T 20 R 19W  
BOOK PAGE 23 LINE 3

MADE IN U.S.A.  
CONSERVATION DIVISION  
STATE CORPORATION COMMISSION  
WICHITA, KANSAS

3-31-1954

CONTRACTOR'S WELL LOG

COMPANY:	TEKKAN OIL COMPANY
CONTRACTOR:	Musgrove Petroleum Corporation
FARM:	CARR #1
LOCATION:	990' from North Line, & 400' from West line, NW/4, Sec. 7-20-19, Pawnee County, Kansas.
COMMENCED:	March 12, 1954
COMPLETED:	March 24, 1954

0	140	Clay & shells
140	1225	Shale & shells
1225	1429	Shale & red bed
1429	1456	Anhydrite
1456	2015	Shale & shells
2015	2265	Shale & lime streaks
2265	3791	Lime & shale
3791	4310	Lime
	4310	Rotary Total Depth

Set 8-5/8" surface casing at 330' with 175 sacks of common cement.  
 Dry and Abandoned.

STATE OF KANSAS )  
 ) SS  
 COUNTY OF SEDGWICK )

I, GORDON L. KOELLING, do hereby certify that the above and foregoing is a true and correct copy of the log of the CARR #1, 990' from the north line and 400' from the west line of NW/4, Section 7-20-19, Pawnee County, Kansas, as reflected by the files of the Musgrove Petroleum Corporation.

MUSGROVE PETROLEUM CORPORATION

BY Gordon L. Koelling  
 Secretary-Treasurer

Subscribed and sworn to before me, a Notary Public, in and for Sedgwick County, Kansas, this 29th day of March, 1954.

Alma E. Rouse  
 Notary Public

My commission expires July 16, 1955.

RECEIVED  
 NOTARY PUBLIC COMMISSION  
 MAR 31 1954  
 CONSERVATION DIVISION  
 Wichita, Kansas

PLUGGING  
 FILE SEC 7 T 20 R 19W  
 BOOK PAGE 23 LINE 3