

STATE OF KANSAS
STATE CORPORATION COMMISSION

WELL PLUGGING RECORD

Give All Information Completely
Make Required Affidavit
Mail or Deliver Report to:
Conservation Division
State Corporation Commission
212 No. Market
Wichita, Kansas

Pawnee County, Sec 7 Twp. 20S Rge. (E) 19 (W)

Location as "NE/CNW/SW" or footage from lines SE NE

Lease Owner Rains & Williamson Oil Co., Inc.

Lease Name CARR Well No. 1

Office Address 1425 Wichita Plaza - Wichita, Kansas

Character of Well (completed as Oil, Gas or Dry Hole) Dry Hole

Date well completed 11-14 19 67

Application for plugging filed 11-14 19 67

Application for plugging approved 11-14 19 67

Plugging commenced 11-14 19 67


Plugging completed 4:50 AM 11-14 19 67

Reason for abandonment of well or producing formation No oil or gas found

in commercial quantities.

If a producing well is abandoned, date of last production -- 19 --

Was permission obtained from the Conservation Division or its agents before plugging was commenced? Yes

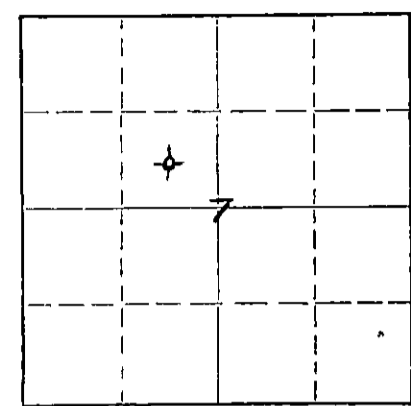

Locate well correctly on above Section Plat

Name of Conservation Agent who supervised plugging of this well Mr. Leo Massey, Hays, Kansas

Producing formation _____ Depth to top _____ Bottom _____ Total Depth of Well 4110' Feet

Show depth and thickness of all water, oil and gas formations.


OIL, GAS OR WATER RECORDS

CASING RECORD

FORMATION	CONTENT	FROM	TO	SIZE	PUT IN	PULLED OUT
					342'	-0-

Describe in detail the manner in which the well was plugged, indicating where the mud fluid was placed and the method or methods used in introducing it into the hole. If cement or other plugs were used, state the character of same and depth placed, from _____ feet to _____ feet for each plug set.

Spotted 100 sacks 50-50 Pozmix, 6% Gel, at 720'.
Spotted 25 sacks 50-50 Pozmix, 6% Gel, at 340'.
Mudded back to 40', set solid bridge and capped with 10 sacks, 2 sacks in rat hole.

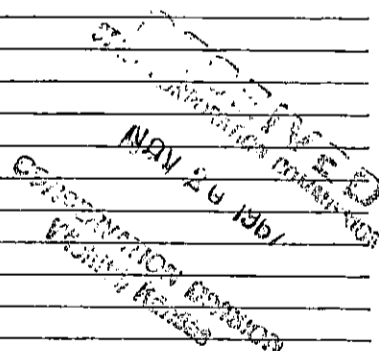

(If additional description is necessary, use BACK of this sheet)

Name of Plugging Contractor Rains & Williamson Oil Co., Inc.
Address 1425 Wichita Plaza - Wichita, Kansas 67202

STATE OF KANSAS, COUNTY OF SEDGWICK, ss. Wilson Rains

(owner or operator) of the above-described well, being first duly sworn on oath, says: That I have knowledge of the facts, statements, and matters herein contained and the log of the above-described well as filed and that the same are true and correct. So help me God.

(Signature) Wilson Rains
1425 Wichita Plaza - Wichita, Kansas
(Address)

SUBSCRIBED AND SWORN to before me this 17th day of November, 19 67

My commission expires June 30, 1971

Sherry Gish Notary Public.

ROTARY DRILLING LOG

15.145.20030.0000

Operator: Rains & Williamson
Oil Co., Inc.
CARR #1
SE LNE Sec. 7-20S-19W
Pawnee County, Kansas

Contractor: Rains & Williamson
Oil Co., Inc.
Commenced: 11-6-67
Completed: 11-14-67
Remarks: Set 8-5/8" surface
casing at 342' w/
180 sx. GL-3 cement

Formations:

Surface Clay	44'
Shale	795'
Sand	1006'
Shale and Red Bed	1280'
Red Bed	1389'
Anhydrite	1415'
Shale	1550'
Shale and Shells	2150'
Lime and Shale	2750'
Shale and Lime	2900'
Shale, Lime and Chalk	3265'
Shale and Lime	3715'
Lime	4110'
Rotary Total Depth (D & A)	4110'

RECORDED
CONSERVATION DIVISION
WICHITA KANSAS



I certify the above log is true and correct to the best of my knowledge and belief.

RAINS & WILLIAMSON OIL CO., INC.

Wilson Rains
Wilson Rains

Subscribed to and sworn before me, a notary public within and for the State of Kansas, County of Sedgwick, this 17th day of November, 1967

Sherry Gish
Sherry Gish Notary Public

My Commission Expires:
June 30, 1971