


WELL PLUGGING RECORD

Give All Information Completely  
Make Required Affidavit  
Mail or Deliver Report to:  
Conservation Division  
State Corporation Commission  
800 Bittling Building  
Wichita, Kansas

Pawnee County. Sec. 7 Twp. 20S Rge. 19W (E) (W)  
Location as "NE/CNW/SW" or footage from lines SE SW SW  
Lease Owner National Cooperative Refinery Association  
Lease Name Schneider Well No. 1  
Office Address 305 Rule Building, Wichita, Kansas  
Character of Well (completed as Oil, Gas or Dry Hole) Oil  
Date well completed February 16, 1955  
Application for plugging filed January 12, 1959  
Application for plugging approved January 14, 1959  
Plugging commenced July 29, 1959  
Plugging completed August 8, 1959  
Reason for abandonment of well or producing formation Depletion

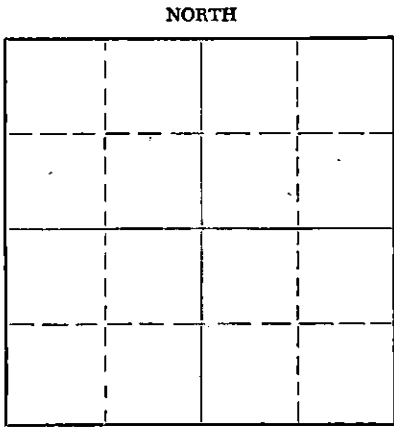

Locate well correctly on above Section Plat

If a producing well is abandoned, date of last production January 15, 1959  
Was permission obtained from the Conservation Division or its agents before plugging was commenced? Yes

Name of Conservation Agent who supervised plugging of this well Frank Broadfoot  
Producing formation \_\_\_\_\_ Depth to top \_\_\_\_\_ Bottom \_\_\_\_\_ Total Depth of Well 4290 Feet  
Show depth and thickness of all water, oil and gas formations.

OIL, GAS OR WATER RECORDS

CASING RECORD

FORMATION	CONTENT	FROM	TO	SIZE	PUT IN	PULLED OUT
				10-3/4"	459'	None-Cemented
				7"	4293'	2517'

Describe in detail the manner in which the well was plugged, indicating where the mud fluid was placed and the method or methods used in introducing it into the hole. If cement or other plugs were used, state the character of same and depth placed, from \_\_\_\_\_ feet to \_\_\_\_\_ feet for each plug set.

Plugged back with sand to 4225'. Dumped 5 sacks of cement to 4200'. Pulled 7" casing. Mudded hole to 240'. Set 10' rock bridge, dumped 30 sacks of cement to 140'. Mudded hole to 30', set 5' rock bridge plus 15 sacks of cement on up to base of cellar.

RECEIVED  
STATE CORPORATION COMMISSION

AUG 20 1959

CONSERVATION DIVISION  
Wichita, Kansas

(If additional description is necessary, use BACK of this sheet)

Name of Plugging Contractor Ace Pipe Pulling Company  
Address Box 304, Great Bend, Kansas

STATE OF Kansas, COUNTY OF Sedgwick, ss.  
C. R. Sears (employee of owner) or (~~owner~~) of the above-described well, being first duly sworn on oath, says: That I have knowledge of the facts, statements, and matters herein contained and the log of the above-described well as filed and that the same are true and correct. So help me God.  
(Signature) C. R. Sears (C. R. Sears)  
305 Rule Building, Wichita, Kansas  
(Address)

SUBSCRIBED AND SWORN to before me this 19th day of August, 1959

My commission expires November 26, 1960 Nell McComb Notary Public.

24-2675-6 2-52-20M

PLUGGING  
FILE SEC. 7 T. 20 R. 19W  
BOOK PAGE 10 LINE 24

Pd  
CHKD 25489  
C-124  
8-20-59  
J.M.

WELL LOG-----

-----SCHNEIDER #1

Location: SE SW, Section 7-20S-19W,  
Pawnee County, Kansas

OWNER: National Cooperative Refinery Association  
ROTARY DRILLING CONTRACTOR: Sterling Drilling Company

COMMENCED: 1-21-55 (w.r.)  
COMPLETED: 2-12-55 (w.r.)

ROTARY TOTAL DEPTH: 4295'


LOG

0-460	Shale & Sand
460-800	Shale
800-1000	Sand
1000-1430	Red Bed & Sand
1430-1905	Shale & Shells
1905-2145	Limestone & Shale
2145-2830	Limestone
2830-3355	Shale & Limestone
3355-3560	Limestone
3560-3680	Limestone & Shale
3680-4225	Limestone
4225-4255	Limestone & Shale
4255-4275	Shale & Sand
4275-4295	Limestone & Chert T.D.

CASING RECORD

Ran 459' of 10-3/4" casing set with  
275 sacks cement.

Set 7" casing at 4293' with 100 sacks  
cement.

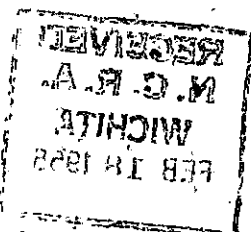

RECEIVED  
STATE CORPORATION

JAN 15 1955

CONSERVATION DIVISION  
Wichita, Kansas

