


STATE OF KANSAS
STATE CORPORATION COMMISSION
CONSERVATION DIVISION
P. O. BOX 17027
WICHITA, KANSAS 67217

FORM CP-4

WELL PLUGGING RECORD

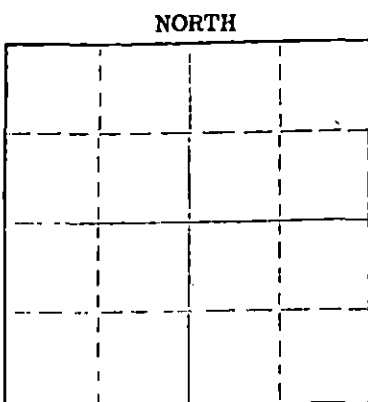

Locate well correctly on above Section Plat

Pawnee County, Sec. 4 Twp. 20S Rge. 19 (E)W (W)
Location as "NE/CNW/SW" or footage from lines C S/2 NE NW
Lease Owner Rains & Williamson Oil Co., Inc.
Lease Name Smith Well No. 1
Office Address 435 Page Court, 220 W. Douglas, Wichita, Ks.
Character of Well (completed as Oil, Gas or Dry Hole) Dry Hole
Date well completed May 27, 1976
Application for plugging filed May 27, 1976
Application for plugging approved May 27, 1976
Plugging commenced May 27, 1976
Plugging completed May 27, 1976
Reason for abandonment of well or producing formation commercial quantities of oil not found
If a producing well is abandoned, date of last production 19
Was permission obtained from the Conservation Division or its agents before plugging was commenced? Yes

Name of Conservation Agent who supervised plugging of this well Leo Massey
Producing formation _____ Depth to top _____ Bottom _____ Total Depth of Well 4380 feet
Show depth and thickness of all water, oil and gas formations.

OIL, GAS OR WATER RECORDS

CASING RECORD

FORMATION	CONTENT	FROM	TO	SIZE	PUT IN	PULLED OUT
				8 5/8"	368'	none

Describe in detail the manner in which the well was plugged, indicating where the mud fluid was placed and the method or methods used in introducing it into the hole. If cement or other plugs were used, state the character of same and depth placed, from _____ feet to _____ feet for each plug set.

Plug at 510' with 50 sx., 300' w/ 25 sx., 40' w/ 10 sx., mixed with 50/50 pos.

RECEIVED
STATE CORPORATION COMMISSION

JUN 16 1976

CONSERVATION DIVISION
WICHITA, KANSAS

Name of Plugging Contractor Rains & Williamson Oil Co., Inc.
Address 435 Page Court, 220 W. Douglas, Wichita, Kansas 67202

STATE OF KANSAS COUNTY OF SEDGWICK, ss.
Wilson Rains, President (employee of owner) or (owner or operator) of the above-described well, being first duly sworn on oath, says: That I have knowledge of the facts, statements, and matters herein contained and the log of the above-described well as filed and that the same are true and correct. So help me God.

(Signature) Wilson Rains
435 Page Court, 220 W. Douglas, Wichita
(Address)

Subscribed and Sworn to before me this 1 day of June, 1976



Janita M. Green
Notary Public.

WELL LOG

15.145.20414.0000

COMPANY Rains & Williamson Oil Co., Inc.

SEC. 4 T. 20S R. 19W
LOC. C S/2 NE NW

FARM Smith NO. 1


RIG. NO. 7

TOTAL DEPTH 4380'

COMM. 5/17/76

COMP. 5/27/76

COUNTY Pawnee
KANSAS

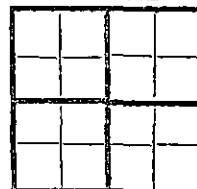

CONTRACTOR Rains & Williamson Oil Co., Inc.

CASING

20 10
15 8 5/8" @ 368' w/225 sx. common
12 6
13 5

ELEVATION 2265 KB

PRODUCTION D & A

FIGURES INDICATE BOTTOM OF FORMATIONS

Shale	840
Sand	1043
Shale	1420
Anhydrite	1452
Shale	2220
Shale & Lime	3037
Shale	3200
Shale & Lime	3890
Lime & Shale	4009
Lime	4245
Lime & Shale	4295
Lime	4380
<u>R.T.D.</u>	<u>4380</u>

RECEIVED
OIL & GAS COMMISSION
JUN 16 1976
L. WILSON RAINS
Wichita, Kansas

State of Kansas
County of Sedgwick } ss:

I, Wilson Rains, President of the Rains & Williamson Oil Co., Inc. company

upon oath state that the above and foregoing is a true and correct copy of the log of the Smith #1 well.

Wilson Rains
WILSON RAINS

Subscribed and sworn to before me this 1 day of June 19 76

My Commission Expires: 10-4-79

Juanita M. Green
NOTARY PUBLIC
Juanita M. Green

