


WELL PLUGGING RECORD

Give All Information Completely
Make Required Affidavit
Mail or Deliver Report to:
Conservation Division
State Corporation Commission
800 Biting Building
Wichita, Kansas

Pawnee County, Sec. 4 Twp. 20 Rge. (E) 19 (W)
Location as "NE/CNW&SW" or footage from lines SW SW SE/4

Lease Owner M. B. Armer
Lease Name Kitch Well No. 1
Office Address 710 Petroleum Bldg., Wichita, Kansas

Character of Well (completed as Oil, Gas or Dry Hole) dry
Date well completed May 16 19 53
Application for plugging filed May 16 19 53
Application for plugging approved May 16 19 53
Plugging commenced May 16 19 53
Plugging completed May 16 19 53
Reason for abandonment of well or producing formation dry

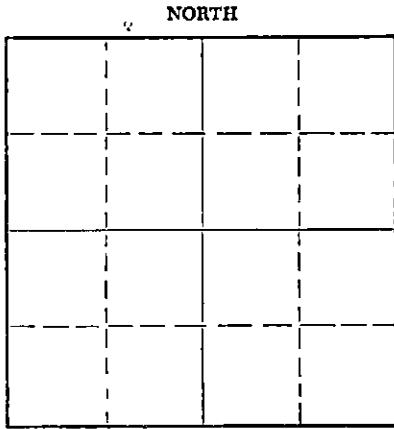

Locate well correctly on above Section Plat

If a producing well is abandoned, date of last production 19
Was permission obtained from the Conservation Division or its agents before plugging was commenced? Yes

Name of Conservation Agent who supervised plugging of this well M. A. Rives
Producing formation _____ Depth to top _____ Bottom _____ Total Depth of Well 4308 Feet
Show depth and thickness of all water, oil and gas formations.

OIL, GAS OR WATER RECORDS

CASING RECORD

FORMATION	CONTENT	FROM	TO	SIZE	PUT IN	PULLED OUT
				8 5/8"	139	None

Describe in detail the manner in which the well was plugged, indicating where the mud fluid was placed and the method or methods used in introducing it into the hole. If cement or other plugs were used, state the character of same and depth placed, from _____ feet to _____ feet for each plug set.

Filled with heavy Rotary mud to 130 ft.
set plug and 15 sacks cement through drill
pipe. Filled with mud to 35 ft, set plug and
10 sacks cement at the surface.

RECEIVED
STATE CORPORATION COMMISSION
MAY 21 1953
CONSERVATION DIVISION
Wichita, Kansas

(If additional description is necessary, use BACK of this sheet)

Name of Plugging Contractor M. B. Armer
Address 710 Petroleum Bldg., Wichita, Kansas

STATE OF KANSAS, COUNTY OF SEDGWICK, ss.
L. C. Sponenberg (employee of owner) or (~~owner or operator~~) of the above-described well, being first duly sworn on oath, says: That I have knowledge of the facts, statements, and matters herein contained and the log of the above-described well as filed and that the same are true and correct. So help me God.

(Signature) L. C. Sponenberg

(Address)

SUBSCRIBED AND SWORN TO before me this 20th day of May, 19 53

Rose Furey
Notary Public.

My commission expires Feb. 13, 1956.

PLUGGING
FILE SEC 4 T 20 R 19W
BOOK PAGE 101 LINE 45

KANSAS WELL LOG BUREAU --- KANSAS GEOLOGICAL SOCIETY

508 EAST MURDOCK - WICHITA, KANSAS

COMPANY **M. B. Armer**

SEC. **4** T. **20S** R. **19W**

FARM **Kitch**

NO. **1**

LOC. **SW SW SE**

TOTAL DEPTH **1308**

COUNTY **Lawrence**


COMM. **5/1/53**

COMP. **5/17/53**

SHOT OR TREATED

CONTRACTOR **M. B. Armer**

ISSUED

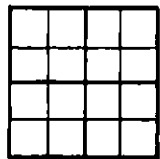

CASING	
20	10
15	8 139'
12	6
13	5

ELEVATION **2259 M.D.**

PRODUCTION

FIGURES INDICATE BOTTOM OF FORMATIONS

Clay & Sand	50
Shells & Shale	650
Red Bed & Shells	830
Sand	980
Red Bed	990
Sand	1030
Red Bed, Shale & Sand "Strks"	1075
Red Bed & Shale	1105
Anhydrite	1140
Shale & Shells	1975
Shale & Lime	2320
Shale, Lime & Red Bed	2475
Lime & Shale	3707
Lime	3993
Lime & Chert	4039
Lime	4125
Shale & Lime	4253
Sand	4255
Shale, lime & Sand	4302
Cherty Conglomerate	4308

FORMATION TOPS
(R. D. Meas.)

HEEBLER	3738
LANSING	3782
CONGLOMERATE SAND	4248

D & A

I hereby certify that this is a true and correct log of the above described well as shown by the drilling reports.

M. B. ARMER

BY *L. C. Spruendy*

STATE OF KANSAS
COUNTY OF SUDWICK

Subscribed and sworn to before me, a notary public, in and for said County and State this 18th day of May, 1953.

Rose Lurvey
Notary Public

My Commission Expires: Feb. 13, 1956.

RECEIVED
REGISTRATION COMMISSION
MAY 19 1953
CONSERVATION DIVISION
Wichita, Kansas

PLUGGING
SEC **4** T **20S** R **19W**
PAGE **101** LINE **45**