


Give All Information Completely
Make Required Affidavit
Mail or Deliver Report to:
Conservation Division
State Corporation Commission
212 North Market, Insurance Bldg.
Wichita, Kansas

WELL PLUGGING RECORD

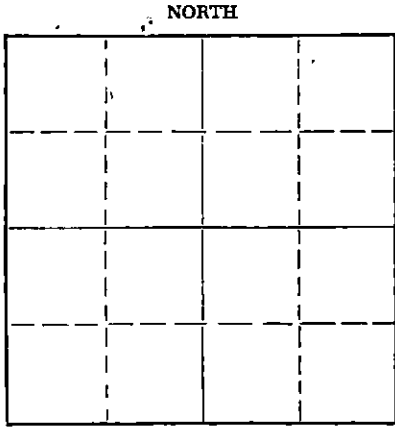

Locate well correctly on above
Section Plat

Pawnee County, Sec. 2 Twp. 20 Rge. (E) 17 (W)
Location as "NE/CNW/SE" or footage from lines SE SE NE
Lease Owner Chief Drilling Co., Inc. & Sunray Mid-Continent Oil Co.
Lease Name Box 97 - Gt. Bend, Kansas Well No. 1
Office Address Behrens
Character of Well (completed as Oil, Gas or Dry Hole) Dry Hole
Date well completed 1/16/ 19 60
Application for plugging filed 1/16/ 19 60
Application for plugging approved 1/16/ 19 60
Plugging commenced 1/16/ 19 60
Plugging completed 1/16/ 19 60
Reason for abandonment of well or producing formation Dry Hole

If a producing well is abandoned, date of last production 19
Was permission obtained from the Conservation Division or its agents before plugging was commenced? Yes

Name of Conservation Agent who supervised plugging of this well Frank Broadfoot - St. John, Kansas
Producing formation Depth to top Bottom Total Depth of Well 3937 Feet
Show depth and thickness of all water, oil and gas formations.

OIL, GAS OR WATER RECORDS

CASING RECORD

FORMATION	CONTENT	FROM	TO	SIZE	PUT IN	PULLED OUT
				8 5/8"	260'	None

Describe in detail the manner in which the well was plugged, indicating where the mud fluid was placed and the method or methods used in introducing it into the hole. If cement or other plugs were used, state the character of same and depth placed, from feet to feet for each plug set.

1/3 sacks hulls & wooden plug @ 240'; mixed 20 sacks cement through drill pipe

1/3 sacks hulls & wooden plug @ 40'; mixed 10 sacks cement

RECEIVED
STATE CORPORATION COMMISSION
JAN 22 1960
CONSERVATION DIVISION

(If additional description is necessary, use BACK of this sheet)
Name of Plugging Contractor Chief Drilling Co., Inc.
Address Box 97 - Gt. Bend, Kansas

STATE OF Kansas, COUNTY OF Barton, ss.
V. Richard Hoover, President (employee of owner) or (owner or operator) of the above-described well, being first duly sworn on oath, says: That I have knowledge of the facts, statements, and matters herein contained and the log of the above-described well as filed and that the same are true and correct. So help me God.

CHIEF DRILLING CO., INC.
(Signature) V. Richard Hoover
Box 97 - Great Bend, Kansas (Address)

SUBSCRIBED AND SWORN TO before me this 18th day of January 19 60

My commission expires May 19, 1962
Norris Taylor Notary Public.

WELL LOG

Chief Drilling Co., Inc. & Sunray Mid-Continent Oil Co.
P.O. Box 97
Great Bend, Kansas

No. 1 Behrens
SE SE NE Sec. 2-20-17W
Pawnee County, Kansas

Contractor: Chief Drilling Co., Inc.
Rotary: 0 - 3967'

Commenced: 1/6/60
Completed: 1/16/60
D & A

Casing Record: 8 5/8" set @ 260' with 175 sacks cement, cement circulated.

<u>FORMATION</u>	<u>FROM</u>	<u>TO</u>	<u>ELEVATION</u>
Shale, Post Rock & Shells	0	260	2135 Gr.
Shale	260	310	2137 D.F.
Red Bed	310	375	2140 K.B.
Sand	375	430	
Shale & Shells	430	585	
Sand	585	740	
Shale & Shells	740	985	
Red Bed & Shale	985	1192	
Anhydrite	1192	1218	
Shale & Shells	1218	1470	
Shale	1470	1880	
Sand	1880	1895	
Shale & Shells	1895	2060	
Lime & Shale	2060	2315	
Lime	2315	2720	
Lime & Shale	2720	3300	
Lime	3300	3500	
Lime & Shale	3500	3555	
Lime	3555	3820	
Shale & Lime	3820	3902	
Dolomite	3902	3937	
Total Depth		3937	

FORMATION TOPS

Heebner	3497
Brown Lime	3465
Lansing	3485
Arbuckle	3902

RECEIVED
STATE CORPORATION COMMISSION
JAN 22 1960
CONSERVATION DIVISION
Wichita, Kansas

STATE OF KANSAS)

SS

COUNTY OF BARTON)

I hereby certify that the above is a true and correct copy of the Driller's Log of the well drilled in the SE SE NE of Section 2-20-17W, Pawnee County, Kansas, to the best of my knowledge and belief.

CHIEF DRILLING COMPANY, INC.

V. Richard Hoover
V. Richard Hoover, President

Subscribed to and sworn to before me this 18th day of January, 1960

My commission expires May 19, 1962

Norris Taylor
Norris Taylor, Notary Public