


STATE OF KANSAS
STATE CORPORATION COMMISSION

WELL PLUGGING RECORD

Give All Information Completely
Make Required Affidavit
Mail or Deliver Report to
Conservation Division
State Corporation Comm.
245 North Water
Wichita, KS 67202

Pawnee County, Sec. 11 Twp. 20 Rge. 18 E/W
Location as "NE/CNW $\frac{1}{4}$ SW $\frac{1}{4}$ " or footage from lines
C-SW $\frac{1}{4}$

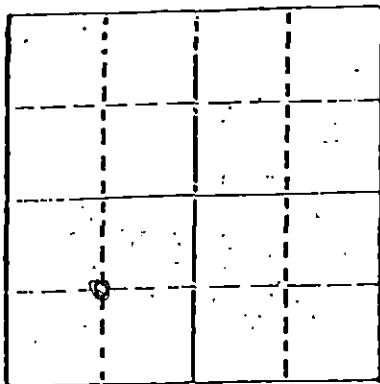

Locate well correctly on above
Section Plat

Lease Owner Anador Resources, Inc.
Lease Name Buckman Well No. 1-11
Office Address 5700 S. Quebec, #320 Englewood, CO 80111
Character of Well (Completed as Oil, Gas or Dry Hole)
Dry hole

Date Well completed 4-4 1981
Application for plugging filed 5-6 1981
Application for plugging approved 19
Plugging commenced 4-4 1981
Plugging completed 4-4 1981
Reason for abandonment of well or producing formation
Not productive
If a producing well is abandoned, date of last production
19

Was permission obtained from the Conservation Division or
its agents before plugging was commenced? Yes

Name of Conservation Agent who supervised plugging of this well Marion Schmidt
Producing formation Depth to top Bottom Total Depth of Well 2230
Show depth and thickness of all water, oil and gas formations.

OIL, GAS OR WATER RECORDS

CASING RECORD

FORMATION	CONTENT	FROM	TO	SIZE	PUT IN	PULLED OUT
Krider	water	2161	2200			
Winfield	water	2214	2250			
Towanda	water	2275	2290			

Describe in detail the manner in which the well was plugged, indicating where the mud fluid
was placed and the method or methods used in introducing it into the hold. If cement or other
plugs were used, state the character of same and depth placed, from feet to
feet for each plug set.

Well was drilled with 9.8 #/gal., 36 Viscosity mud. Cement plugs were placed
through drill pipe as follows:

- 65 sxs. @ 1020'
- 30 sxs. @ 330'
- 10 sxs. @ surface

RECEIVED
MAY 1 1981
CONSERVATION DIVISION
WICHITA, KANSAS

(If additional description is necessary, use BACK of this sheet)

Name of Plugging Contractor Sun Oil Well Cementers

STATE OF Colorado COUNTY OF Arapahoe, ss.
David Dudzik (employee of owner) or (owner or operator)
of the above-described well, being first duly sworn on oath, says: That I have knowledge of
the facts, statements, and matters herein contained and the log of the above-described well
as filed and that the same are true and correct. So help me God.

(Signature)

David Dudzik

5700 S. Quebec, Suite 320 Englewood, CO
(Address)

SUBSCRIBED AND SWORN TO before me this 6th day of May, 1981

Keis Ann Rosengren
KEIS ANN ROSENGREN Notary Public.

My commission expires Sept. 15, 1984

KANSAS

WELL COMPLETION REPORT AND DRILLER'S LOG


S. 11 T. 20 R. 18 ^{X6} W

API No. 15 — 145 — 20,837 - 6000
County Number

Loc. C-SW¹/₄

County Pawnee

640 Acres
N

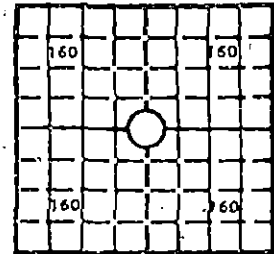

Locate well correctly

Elev.: Gr. 2168

DF. KB 2170

Operator
Anador Resources, Inc.

Address
5700 S. Quebec, Suite 320 Englewood, CO 80111

Well No. 1-11 Lease Name Buckman

Footage Location
1320 feet from (N) (S) line 1320 feet from (E) (W) line

Principal Contractor Western Well Drilling Geologist George Reid

Spud Date 3-20-81 Date Completed 4-4-81 Total Depth 2330 P.B.T.D.

Directional Deviation Oil and/or Gas Purchaser

CASING RECORD

Report of all strings set — surface, intermediate, production, etc.

Purpose of string	Size hole drilled	Size casing set (in O.D.)	Weight lbs/ft.	Setting depth	Type cement	Sacks	Type and percent additives
Surface	9 7/8"	7"	17	1020	50-50 POZ	300	3% CaCl

LINER RECORD

PERFORATION RECORD

Top, ft.	Bottom, ft.	Sacks cement	Shots per ft.	Size & type	Depth interval

TUBING RECORD

Size	Setting depth	Packer set at

ACID, FRACTURE, SHOT, CEMENT SQUEEZE RECORD

Amount and kind of material used	Depth interval treated

INITIAL PRODUCTION

Date of first production Producing method (flowing, pumping, gas lift, etc.)

RATE OF PRODUCTION PER 24 HOURS	Oil	Gas	Water	Gas-oil ratio
	bbls.	MCF	bbls.	CFPB

Disposition of gas (vented, used on lease or sold) Producing interval (s)

RECEIVED
MAY 2 1981
CONSERVATION DIVISION
WICHITA, KANSAS

INSTRUCTIONS: As provided in KCC Rule 82-2-125, within 90 days after completion of a well, one completed copy of this Drillers-Log shall be transmitted to the State Geological Survey of Kansas, 4150 Monroe Street, Wichita, Kansas 67209. Copies of this form are available from the Conservation Division, State Corporation Commission, 245 No. Water, Wichita, Kansas 67202. Phone AC 316-522-2206. If confidential custody is desired, please note Rule 82-2-125. Drillers Logs will be an open file in the Oil and Gas Division, State Geological Survey of Kansas, Lawrence, Kansas 66044.

Operator Anador Resources, Inc. DESIGNATE TYPE OF COMP.: OIL, GAS, DRY HOLE, SWDW, ETC.: Dry hole

Well No. 1-11 Lease Name Buckman

S 11 T 20 R 18 E W

WELL LOG
 Show all important zones of porosity and contents thereof; cored intervals, and all drill-stem tests, including depth interval tested, cushion used, time tool open, flowing and shut-in pressures, and recoveries. SHOW GEOLOGICAL MARKERS, LOGS RUN, OR OTHER DESCRIPTIVE INFORMATION.

FORMATION DESCRIPTION, CONTENTS, ETC.	TOP	BOTTOM	NAME	DEPTH
Krider - water	2161	2200	Stone Corral	1230'
Winfield - water	2214	2250	Hutchinson	
			Salt	1660'
Towanda - water	2275	2290		
<p>Well was cored from 2158' (T.D.). Core analysis and descriptions are attached. Drill stem tests were attempted over the following intervals: 2270' - 2330', 2210' - 2255', 2160' - 2205', and 2145' - 2190'. Copies of tests and results are attached.</p>				

USE ADDITIONAL SHEETS, IF NECESSARY, TO COMPLETE WELL RECORD.

Date Received

David D. Wolf
 Signature
 Chief Engineer
 Title
 5-6-81
 Date