

WELL PLUGGING RECORD

Give All Information Completely
Make Required Affidavit
Mail or Deliver Report to:
Conservation Division
State Corporation Commission
800 Bittling Building
Wichita, Kansas

NORTH

Locate well correctly on above
Section Plat

Pawnee County. Sec. 10 Twp. 20 Rge. (E) 18(W)
Location as "NE/CNW/SW" or footage from lines. NW NW NW
Lease Owner Morrison Drilling Company, Inc.
Lease Name Vaughan Well No. 1
Office Address Drawer 712, El Dorado, Kansas
Character of Well (completed as Oil, Gas or Dry Hole) Dry Hole
Date well completed March 20 19 54
Application for plugging filed Verbal March 20 19 54
Application for plugging approved Verbal March 20 19 54
Plugging commenced March 21 19 54
Plugging completed March 21 19 54
Reason for abandonment of well or producing formation _____

If a producing well is abandoned, date of last production _____ 19 _____
Was permission obtained from the Conservation Division or its agents before plugging was commenced? Yes

Name of Conservation Agent who supervised plugging of this well Mr. Rives
Producing formation _____ Depth to top _____ Bottom _____ Total Depth of Well 4079 Feet
Show depth and thickness of all water, oil and gas formations.

OIL, GAS OR WATER RECORDS

CASING RECORD

FORMATION	CONTENT	FROM	TO	SIZE	PUT IN	PULLED OUT

Describe in detail the manner in which the well was plugged, indicating where the mud fluid was placed and the method or methods used in introducing it into the hole. If cement or other plugs were used, state the character of same and depth placed, from _____ feet to _____ feet for each plug set.

Gunned rotary pits up good. Filled hole with thick rotary mud to 270' of top of hole. Wrapped up 2 gallons of Halls and pushed ahead of Halliburton Plug to fluid. Filled hole to 40'. Pushed another batch of hells down with Halliburton Plug and capped with 10 sacks of cement.

(If additional description is necessary, use BACK of this sheet)


Name of Plugging Contractor Morrison Drilling Company, Inc.
Address Drawer 712, El Dorado, Kansas

STATE OF KANSAS, COUNTY OF BUTLER, ss.
C. W. Wilson (employee of owner) ~~owner or operator~~ of the above-described well, being first duly sworn on oath, says: That I have knowledge of the facts, statements, and matters herein contained and the log of the above-described well as filed and that the same are true and correct. So help me God

(Signature) [Signature]
Drawer 712, El Dorado, Kansas
(Address)

SUBSCRIBED AND SWORN to before me this 24th day of March, 19 54

My commission expires January 10, 1955. [Signature] Notary Public.

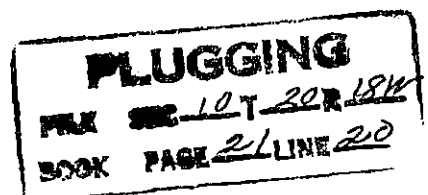

WELL LOG-VAUGHAN #1

OPERATOR: Morrison Drilling Company, Inc. LOCATION: NW/4 NW/4 NW/4
 Drawer 712 Section 10-20S-18W
 El Dorado, Kansas Pawnee County, Kansas

CONTRACTOR: Morrison Drilling Company, Inc. PRODUCTION: _____
 Drawer 712, El Dorado, Kansas

Farm: Vaughan Well No. 1 Field:
 Date Commenced: March 5, 1954
 Date Completed: March 20, 1954

Total Depth: 4079 - Rotary

<u>From</u>	<u>To</u>	<u>Formation</u>
0	35	Surface Soil & Clay
35	70	Shale & Lime Streaks
70	281	Shale & Lime Shells
281	315	Shale & Shells
315	370	Sand
370	600	Shale and Shells
600	810	Red Bed
810	880	Shale & Shells
880	1110	Shale & Red Bed Streaks
1110	1256	Shale and Shells
1256	1290	Lime
1290	1400	Red Bed
1400	1635	Shale and Lime Streaks
1635	1900	Shale and Lime Shells
1900	1985	Lime and Shale
1985	2105	Lime and Shale Breaks
2105	2170	Lime
2170	2285	Shale and Lime
2285	2390	Lime and Shale
2390	2445	Lime
2445	2480	Lime
2480	2565	Lime and Shale Streaks
2565	2640	Lime and Shale
2640	2710	Lime and Shale Streaks
2710	2855	Lime and Shale
2855	2960	Lime and Shale Streaks
2960	3010	Shale
3010	3287	Shale and Lime
3287	3540	Lime
3540	3572	Lime and Shale
3572	3610	Lime
3610	3627	Shale
3627	3662	Lime - Kansas City
3662	3918	Lime
3918	3929	Shale and Lime Streaks
3929	3990	Shale and Lime
3990	4025	Lime
4025	4039	Lime and Shale
4039	4079	Arbuckle Lime
4079		Total Depth

I hereby certify that the foregoing is a true and correct copy of the Well Log for the Vaughan #1 well drilled for Morrison Drilling Company, Inc. and completed March 20, 1954.

MORRISON DRILLING COMPANY, INC.

C. W. Wilson
 C. W. Wilson - Secretary-Treasurer

RECEIVED
 MARCH 21 1954

PLUGGING
 SEC 10 T 20S 18W
 PAGE 21 LINE 20

STATE OF KANSAS)
COUNTY OF BUTLER) ss:

SUBSCRIBED AND SWORN TO, Before the Undersigned, a Notary Public, in and for the County and State aforesaid this 24th day of March, 1954.

Ann Biles
Notary Public

My Commission Expires January 10, 1955.

STATE OF KANSAS
COUNTY OF BUTLER

PLUGGING
PAGE 107-20-18
BOOK PAGE 2/LINE 20