


STATE OF KANSAS  
STATE CORPORATION COMMISSION

WELL PLUGGING RECORD

Give All Information Completely  
Make Required Affidavit  
Mail or Deliver Report to:  
Conservation Division  
State Corporation Commission  
800 Bitting Building  
Wichita, Kansas

NORTH

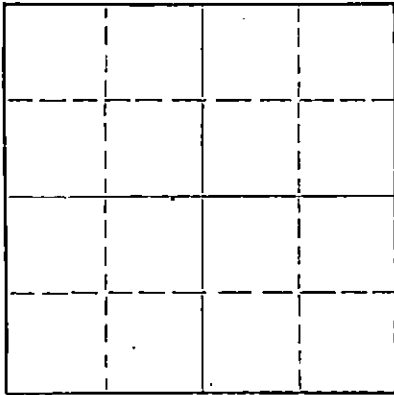

Locate well correctly on above  
Section Plat

Pawnee County. Sec. 7 Twp. 20 Rge. (E) 18 (W)  
Location as "NE/CNW/SW" or footage from lines NW NW SE  
Lease Owner Jones, Shelburne & Farmer, Inc.  
Lease Name GILLESPIE Well No. 1  
Office Address Russell, Kansas  
Character of Well (completed as Oil, Gas or Dry Hole) Dry  
Date well completed 8-28 1955  
Application for plugging filed 8-28 1955  
Application for plugging approved 8-28 1955  
Plugging commenced 8-28 1955  
Plugging completed 8-28 1955  
Reason for abandonment of well or producing formation Dry

If a producing well is abandoned, date of last production \_\_\_\_\_ 19\_\_\_\_  
Was permission obtained from the Conservation Division or its agents before plugging was commenced? Yes

Name of Conservation Agent who supervised plugging of this well Eldon Petty  
Producing formation \_\_\_\_\_ Depth to top \_\_\_\_\_ Bottom \_\_\_\_\_ Total Depth of Well 4273 Feet  
Show depth and thickness of all water, oil and gas formations.


OIL, GAS OR WATER RECORDS

CASING RECORD

FORMATION	CONTENT	FROM	TO	SIZE	PUT IN	PULLED OUT
				<u>8-5/8</u>	<u>202</u>	<u>None</u>

Describe in detail the manner in which the well was plugged, indicating where the mud fluid was placed and the method or methods used in introducing it into the hole. If cement or other plugs were used, state the character of same and depth placed, from \_\_\_\_\_ feet to \_\_\_\_\_ feet for each plug set.

- Filled hole with heavy mud
- Pushed plug to 197'
- Dumped 1/2 sack hulls on top of plug
- Mixed 15 sacks cement and dumped on top of hulls
- Filled hole to top
- Pushed plug to 40'
- Dumped in 1/2 sack hulls
- Mixed 10 sacks cement and filled hole to top with same.

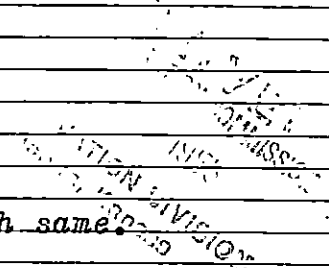


(If additional description is necessary, use BACK of this sheet)  
Name of Plugging Contractor Jones, Shelburne & Farmer, Inc.  
Address Russell, Kansas

STATE OF Kansas, COUNTY OF Russell, ss.  
JOHN O. FARMER (employee or owner) or (owner or operator) of the above-described well, being first duly sworn on oath, says: That I have knowledge of the facts, statements, and matters herein contained and the log of the above-described well as filed and that the same are true and correct. So help me God.

(Signature) John O. Farmer  
Russell, Kansas (Address)

SUBSCRIBED AND SWORN TO before me this 29th day of August, 19 55

My commission expires October 11, 1958  
Lucille Turner Notary Public.

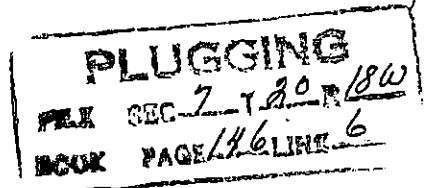

OPERATOR Jones, Shelburne & Farmer, Inc.

15.145.00399.0000

FORMATION RECORD

ADDRESS Russell, Kansas

Give detailed description and thickness of all formations drilled through, contents of sand, whether dry, water, oil or gas.

640 Acres  
N

COUNTY Pawnee SEC. 7 TWP. 20 RGE. 18

COMPANY OPERATING Jones, Shelburne & Farmer, Inc.

OFFICE ADDRESS Russell, Kansas

FARM NAME GILLESPIE WELL NO. 1

DRILLING STARTED 8-12-55 DRILLING FINISHED 8-27-55


DATE OF FIRST PRODUCTION \_\_\_\_\_ COMPLETED \_\_\_\_\_

WELL LOCATED NW 1/4 NW 1/4 SE 1/4 North of South

Line and \_\_\_\_\_ ft. East of West \_\_\_\_\_ Quarter Section

Elevation (Relative to sea level) DERRICK FLOOR 2245 GROUND 2238

CHARACTER OF WELL (Oil, gas or dryhole) Dry

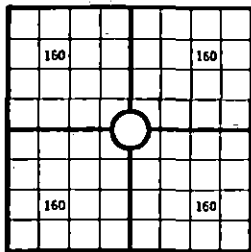

Locate well correctly

OIL OR GAS SANDS OR ZONES

Name	From	To	Name	From	To
1			4		
2			5		
3			6		

Perforating Record If Any

Shot Record

Formation	From	To	No. of Shots	Formation	From	To	Size of Shot

CASING RECORD

Amount Set						Amount Pulled				Packer Record	
Size	Wt.	Thds.	Make	Ft.	In.	Ft.	In.	Size	Length	Depth Set	Make
8-5/8				202							

Liner Record: Amount \_\_\_\_\_ Kind \_\_\_\_\_ Top \_\_\_\_\_ Bottom \_\_\_\_\_

CEMENTING AND MUDDING

Size	Amount Set		Sacks Cement	Chemical		Method of Cementing	Amount	Mudding Method	Results (See Note)
	Ft.	In.		Gal.	Make				
8-5/8	202		150						

Note: What method was used to protect sands if outer strings were pulled? \_\_\_\_\_

NOTE: Were bottom hole plugs used? \_\_\_\_\_ If so, state kind, depth set and results obtained \_\_\_\_\_

TOOLS USED

Rotary Tools were used from \_\_\_\_\_ feet to \_\_\_\_\_ Cable tools were used from \_\_\_\_\_ feet to \_\_\_\_\_ feet, and from \_\_\_\_\_ feet to \_\_\_\_\_ feet, and from \_\_\_\_\_ feet to \_\_\_\_\_ feet to \_\_\_\_\_

Type Rig \_\_\_\_\_

INITIAL PRODUCTION TEST

Describe initial test: whether by flow through tubing or casing or by pumping \_\_\_\_\_

Amount of Oil Production \_\_\_\_\_ bbls. Size of choke, if any \_\_\_\_\_ Length of test \_\_\_\_\_ Water

Production \_\_\_\_\_ bbls. Gravity of oil \_\_\_\_\_ Type of Pump if pump is used, describe \_\_\_\_\_

Formation	Top	Bottom	Formation	Top	Bottom
Surface	0	204			
Shale & Red Beds	204	510			
Sand & shale	510	720			
Sand	720	895			
Shale & shells	895	935			
Sand & shale	935	1035			
Red Bed	1035	1370			
Anhydrite	1370	1405			
Shale & shells	1405	1475			
Shale & shells	1475	1830			
Shale Shells & Salt	1830	2060			
Shale & lime	2060	2370			
Lime & shale	2370	2575			
Lime	2575	2620			
Shale & lime	2620	3025			
Lime & shale	3025	3565			
Lime	3565	3680			
Lime & shale	3680	3711			
Lime	3711	4075			
Cong.	4075	4117			
Lime & shale	4117	4142			
Cherty	4142	4162			
Shale & chert	4162	4179			
Simpson	4179	4200			
Shale & Conglomerate	4200	4235			
Arbuckle	4235	4273			
T.D.		4273			

RECEIVED  
 STATE CORPORATION COMMISSION  
 SEP 1 1955  
 CONSERVATION DIVISION  
 Topeka, Kansas

 BOOK PAGE 146 LINE 6

TOPS: \_\_\_\_\_ Log.

Elevation RB 2245

Heebner 3683 3683

Toronto 3700 3700

Douglas 3715 3714

Lansing 3733 3732

BKC 4030 4030

Cherty Cong. 4143 4144

Simpson Sd. 4170 4172

Arbuckle 4233 4229

T.D. 4273 4274

D & A

I, the undersigned, being first duly sworn upon oath, state that this well record is true, correct and complete according to the records of this office and to the best of my knowledge and belief.

Jones, Shelburne & Farmer Vice-President  
 Name and title of representative of company

Subscribed and sworn to before me this 29th day of August, 1955  
 My Commission expires 10-11-58  
Lucille Hunsley  
 Notary Public

FARM NAME GILLESPIE WELL NO. 1 COUNTY Pawnee TWP. 20 RGE. 18