


STATE OF KANSAS  
STATE CORPORATION COMMISSION

WELL PLUGGING RECORD

Give All Information Completely  
Make Required Affidavit  
Mail or Deliver Report to:  
Conservation Division  
State Corporation Commission  
211 No. Broadway  
Wichita, Kansas

NORTH

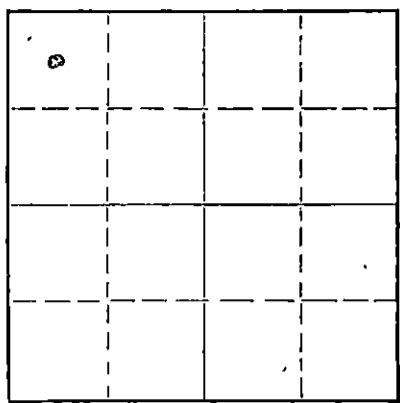

Locate well correctly on above  
Section Plat

Kiowa County. Sec 24 Twp. 28 Rge. 19 W (W)  
Location as "NE/CNW/SW" or footage from lines C, NW NW  
Lease Owner E. K. Carey Drilling Co., Inc.  
Lease Name Seacat Well No. 1  
Office Address Box 620, McPherson, Kansas  
Character of Well (completed as Oil, Gas or Dry Hole) Oil Well  
Date well completed July 23, 19 57  
Application for plugging filed October 10, 19 58  
Application for plugging approved October 13, 19 58  
Plugging commenced Mar. 11 19 59  
Plugging completed Mar. 18 19 59  
Reason for abandonment of well or producing formation Non Productive

If a producing well is abandoned, date of last production October 11, 19 58  
Was permission obtained from the Conservation Division or its agents before plugging was commenced? Yes

Name of Conservation Agent who supervised plugging of this well Mr. Lac-Kamp  
Producing formation \_\_\_\_\_ Depth to top \_\_\_\_\_ Bottom \_\_\_\_\_ Total Depth of Well 4346 Feet  
Show depth and thickness of all water, oil and gas formations.

OIL, GAS OR WATER RECORDS

CASING RECORD

FORMATION	CONTENT	FROM	TO	SIZE	PUT IN	PULLED OUT
				8-5/8"	313'	None
				5-1/2"	4956'	3716'

Describe in detail the manner in which the well was plugged, indicating where the mud fluid was placed and the method or methods used in introducing it into the hole. If cement or other plugs were used, state the character of same and depth placed, from \_\_\_\_\_ feet to \_\_\_\_\_ feet for each plug set.

Fill back to 4260' with sand. Dumped 5 sacks of cement.  
Shot pipe off at 3716', pulled pipe and mudded hole to  
300'. Set rock bridge and dumped 20 sacks of cement.  
Mudded to 40' and set rock bridge. Finished mudding  
hole and dumped 10 sacks of cement in top of surface.

RECEIVED  
STATE CORPORATION COMMISSION  
MAR 27 1959  
CONSERVATION DIVISION  
Wichita

(If additional description is necessary, use BACK of this sheet)

Name of Plugging Contractor \_\_\_\_\_  
Address \_\_\_\_\_

STATE OF Kans. COUNTY OF Reno, ss.  
Employee (employee of owner) or (owner or operator) of the above-described well, being first duly sworn on oath, says: That I have knowledge of the facts, statements, and matters herein contained and the log of the above-described well as filed and that the same are true and correct. So help me God.

(Signature) Dorothy Lee  
R. R. #4, Hutchinson, Kans.  
(Address)

SUBSCRIBED AND SWORN TO before me this 20th day of March, 19 59

Dorothy Lee  
Notary Public.

My commission expires August 12, 1961

PLUGGING  
FILE SEC. 24 T. 28 R. 19W  
BOOK PAGE 135 LINE 41

(COPY)

WELL LOG

(COPY)

Company - The E. K. Carey Drilling Co., Inc.

Farm - Otto S. Seacat No. 1

Sec. 24-28-19W, C, NW NW

County - Kiowa

Total Depth - 4912

Comm: 7-6-57

Comp: 7-23-57

Elev. 2265 D.F.

Contractor - Lewis Drilling Company

Casing: 8-5/8" @ 305' w/250 sks. Pozmix.

5-1/2" @ 4912' w/175 " "

0-275	Surface soil, sand & gravel
275-335	Shale
335-1150	Shale & Red bed
1150-1550	Shale
1550-1815	Shale & Anhydrite
1815-2085	Shale & salt
2085-2230	Shale
2230-4370	Shale & lime
4370-4731	Lime
4731-4868	Lime & shale
4868-4881	Lime
4881-4912	Chert & lime
4912	Total Depth

Geologist Tops

Heebner	4090
Lansing	4250
Mississippian	4854
Total Depth	4912

RECEIVED  
STATE CORP. COMMISSION

APR 1 1959

CONSERVATION DIVISION  
Wichita, Kansas

State of Kansas

County of Sedgwick

I, William J. Duckett of the Lewis Drilling Company upon oath that the above and foregoing is a true and correct copy of the log of the Otto S. Seacat #1 well.

William J. Duckett

Subscribed and sworn to before me this 26th day of July, 1957

Seal

My Commission Expires: 8-20-60

A. R. Derrington  
Notary Public

PLUGGING  
FILE SEC. 24 T. 28 R. 19W  
BOOK PAGE 135 LINE 41