


STATE OF KANSAS  
STATE CORPORATION COMMISSION

Form CP-4

Give All Information Completely  
Make Required Affidavit  
Mail or Deliver Report to:  
Conservation Division  
State Corporation Commission  
P. O. Box 17027  
Wichita, Kansas 67217  
NORTH

WELL PLUGGING RECORD

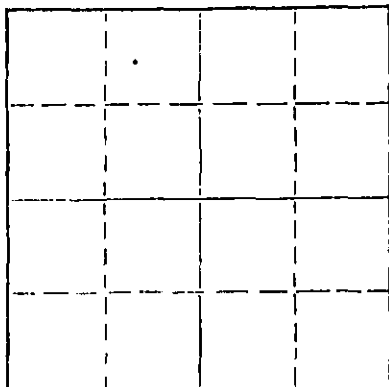

Locate well correctly on above  
Section Flat

Kiowa County, Sec. 26 Twp. 28S Rge. 19W (E) (W)  
Location as "NE/CNW/SE/SW" or footage from lines SE NW  
Lease Owner Patton Oil Company  
Lease Name Vieux Well No. 1  
Office Address Suite 1000, Continental Nat'l. Bank Bldg., 3333 S. Bannock  
Character of Well (completed as Oil, Gas or Dry Hole) Englewood, Colo. D & A  
Date well completed September 30 19 74  
Application for plugging filed September 30 19 74  
Application for plugging approved September 30 19 74  
Plugging commenced September 30 19 74  
Plugging completed September 30 19 74  
Reason for abandonment of well or producing formation D & A

If a producing well is abandoned, date of last production 19  
Was permission obtained from the Conservation Division or its agents before plugging was commenced? Yes

Name of Conservation Agent who supervised plugging of this well Mr. G.R. Biberstein  
Producing formation Depth to top Bottom Total Depth of Well 4,960 Feet  
Show depth and thickness of all water, oil and gas formations.

OIL, GAS OR WATER RECORDS

CASING RECORD

FORMATION	CONTENT	FROM	TO	SIZE	PUT IN	PULLED OUT
				8-5/8"	336'	-0-

Describe in detail the manner in which the well was plugged, indicating where the mud fluid was placed and the method or methods used in introducing it into the hole. If cement or other plugs were used, state the character of same and depth placed, from feet to feet for each plug set.

35 sx @ 300'  
15 sx @ 40'  
Total 50 sx cmt by Allied Cmt Co

RECEIVED  
STATE CORPORATION COMMISSION  
NOV 18 1974  
CONSERVATION DIVISION  
Wichita, Kansas


(If additional description is necessary, use BACK of this sheet)  
Name of Plugging Contractor Red Tiger Drilling Co.  
Address 1720 Wichita Plaza, Wichita, Kansas 67202

STATE OF Kansas, COUNTY OF Sedgwick, ss.  
Linda H. Dickens (employee of owner) or (owner or operator) of the above-described

well being first duly sworn on oath, says: That I have knowledge of the facts, statements, and matters herein contained and the log of the well being described well as filed and that the same are true and correct. So help me God.

(Signature) Linda N. Dickens  
1720 Wichita Plaza, Wichita, Kansas 67202  
(Address)

My Comm. Exp. Dec. 28, 1977  
WORN TO before me this 4th day of October, 19 74

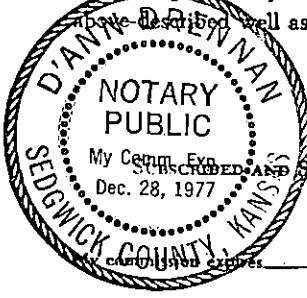

December 28, 1977  
D'Ann Durann  
Notary Public.

DRILLERS LOG

No. 1 Vieux

CASING RECORD:

8-5/8" @ 336'  
w/300' sx. cmt.

TOTAL DEPTH: 4,960'

COMPANY:

Patton Oil Company

CONTRACTOR:

Red Tiger Drilling Company

COMMENCED:

September 9, 1974

COMPLETED:

September 30, 1974

DESCRIPTION:

SE NW  
26-28S-19W  
Kiowa County,  
Kansas

ELEVATION: 2,285' KB

FORMATION

FROM

TO

REMARKS

Shale  
Shale & Sand  
Shale  
Shale & Lime  
Shale  
Shale & Lime  
Lime & Shale  
Lime  
Lime & Chert

0  
100  
1100  
2090  
2369  
2413  
3410  
3870  
4950

100  
1100  
2090  
2369  
2413  
3410  
3870  
4950

Hard Sand 615-633

RECEIVED  
STATE CORPORATION COMMISSION  
NOV 11 1974  
CONSERVATION DIVISION  
Wichita, Kansas

I certify that this is a true and correct copy of the above log to the best of my knowledge.

RED TIGER DRILLING COMPANY

Linda N. Dickens  
Linda H. Dickens

Subscribed and sworn to before me this 4th day of October, 1974.

Diann Drennan  
Notary Public

My Commission Expires:

December 28, 1977

