


Give All Information Completely  
Make Required Affidavit  
Mail or Deliver Report to:  
Conservation Division  
State Corporation Commission  
800 Biting Building  
Wichita, Kansas

WELL PLUGGING RECORD

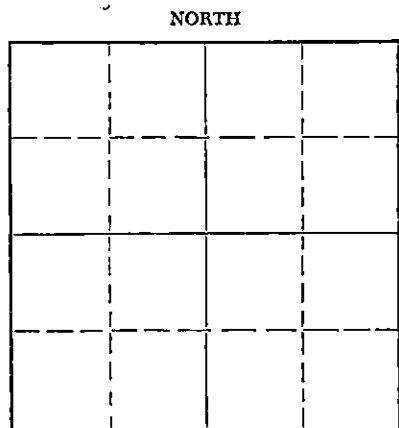

Locate well correctly on above  
Section Plat

Palmer County. Sec. 11 Twp. 20 Rge. (E) 20 (W)  
Location as "NE/CNW/SW" or footage from lines 330' N. & 330' E. of S/4 Corner  
Lease Owner Cities Service Oil Company  
Lease Name Hazlett "B" Well No. 2  
Office Address Great Bend, Kansas  
Character of Well (completed as Oil, Gas or Dry Hole) Dry Hole  
Date well completed June 21, 19 54  
Application for plugging filed June 21, 19 54  
Application for plugging approved June 21, 19 54  
Plugging commenced June 21, 19 54  
Plugging completed June 21, 19 54  
Reason for abandonment of well or producing formation Dry Hole

If a producing well is abandoned, date of last production ---- 19 ---  
Was permission obtained from the Conservation Division or its agents before plugging was commenced? Yes

Name of Conservation Agent who supervised plugging of this well M. A. Rives  
Producing formation Mississippi Depth to top --- Bottom 4315 Total Depth of Well 4315 Feet  
Show depth and thickness of all water, oil and gas formations.

OIL, GAS OR WATER RECORDS

CASING RECORD

FORMATION	CONTENT	FROM	TO	SIZE	PUT IN	PULLED OUT
				8-5/8"	464'	None

Describe in detail the manner in which the well was plugged, indicating where the mud fluid was placed and the method or methods used in introducing it into the hole. If cement or other plugs were used, state the character of same and depth placed, from --- feet to --- feet for each plug set.

4315-300', heavy mud.  
300-233', wood plug, 1/2 sack hulls, 7' dry soil, 20 sacks cement.  
233- 35', heavy mud.  
35' to base of cellar, 1/2 sack hulls, 2' dry soil, 10 sacks cement.

(If additional description is necessary, use BACK of this sheet)

Name of Plugging Contractor Brack Drilling Company, Inc.  
Address Wichita, Kansas

STATE OF Kansas, COUNTY OF Barton, ss.  
V. M. Conover (employee of owner) or (~~owner or operator~~) of the above-described well, being first duly sworn on oath, says: That I have knowledge of the facts, statements, and matters herein contained and the log of the above-described well as filed and that the same are true and correct. So help me God.

(Signature) V. M. Conover  
Box 751, Great Bend, Kansas  
(Address)

SUBSCRIBED AND SWORN to before me this 22nd day of June, 19 54

My commission expires March 12, 1955.

24-7988-5 3-53-20M

**PLUGGING**  
FILE SEC 11 T20 R 20W  
301 PAGE 43 LINE 1

**RECEIVED**  
STATE CORPORATION COMMISSION Notary Public.  
JUN 25 1954  
CONSERVATION DIVISION  
Wichita, Kansas

# WELL RECORD

15.145.00952.0000

Company City Service Oil Company Well No. 2 Farm Henlett "B"  
 Location 330' North and 330' East of 3/4 Cor. Sec. 11 T. 20 R. 20W  
 Elevation 2220 (2210 Cr) County Polk State Kansas  
 Drlg. Comm. June 7, 1954 Contractor Gen. F. Frank Oil Co., Inc.  
 Drlg. Comp. June 30, 1954 Acid None  
 T. D. 4315' Initial Prod. None - P. F. A. 6-21-54

**CASING RECORD:**

8-5/8" 3 464' con. 300 sec cement

**FORMATION RECORD:**

shale & sand streaks	0-312
sand, shale & shells	465
shale & red bed	785
sand	1035
red bed & shale	1365
anhydrite	1395
shale & red bed	1425
red bed, shale & salt	1700
salt	1775
shale	2090
shale & broken lime	2150
lime	2635
lime & shale	3065
shale & lime	3200
lime & shale	3460
broken lime	3545
lime & shale	3690
lime	4165
lime, shale & sand	4200
shale & sand	4236
lime & shale	4288
conglomerate	4308
chert	4315 T. D.

Heebner	3683'
Dodge	3704'
Lansing	3732'
Base Kansas City	4065'
Cherokee	4267'
Basal Penn. Sand	4222'
Conglomerate	4274'
Mississippi	4308'
Penetration	7'
Total Depth	4315'

D. S. T. 4200-4210, open 30 mins., recovered 10' mud; B. H. P. 0#/30 mins.

D. S. T. 4221-33, open 30 mins., recovered 3' mud; B. H. P. 0#/30 mins.

D. S. T. 4235-56, open 30 mins., recovered 6' mud; B. H. P. 0#/30 mins.

**SLOPE TESTS (SURE SHOT):**

450'	1°
1000'	1°
1500'	1°
2000'	3/4°
2500'	1°
3000'	1/2°

**PLUGGING**  
 FILE REC 11 720 R 20W  
 BOOK PAGE 43 LINE 4

STATE OF KANSAS  
 DEPARTMENT OF REVENUE  
 TO BE FILED IN THE OFFICE OF THE  
 COMMISSIONER OF REVENUE  
 AT TOPEKA, KANSAS