

WELL PLUGGING RECORD

Give All Information Completely
Make Required Affidavit
Mail or Deliver Report to
Conservation Division
State Corporation Comm.
245 North Water
Wichita, KS 67202

Pawnee County Sec. 11 Twp. 20s Rge. 20 E/W
Location as "NE/CNW/SW" or footage from lines
C/NW/NW

Lease Owner Liberty Enterprises, Inc.

Lease Name Seltman Well No. 1

Office Address 308 West Mill Plainville KS 67663

Character of Well (Completed as Oil, Gas or Dry Hole)

Dry Hole

Date Well completed March 11, 19 81

Application for plugging filed March 11 19 81

Application for plugging approved March 11 19 81

Plugging commenced 5:30 P.M. March 11 19 81

Plugging completed 7:15 P.M. March 11 19 81

Reason for abandonment of well or producing formation
No Commercial Production

If a producing well is abandoned, date of last production
 19


Was permission obtained from the Conservation Division or
its agents before plugging was commenced? yes

Name of Conservation Agent who supervised plugging of this well Marion Schmidt

Producing formation Depth to top Bottom Tl. Depth of Well

Show depth and thickness of all water, oil and gas formations.

locate well correctly
on above
Section Plot

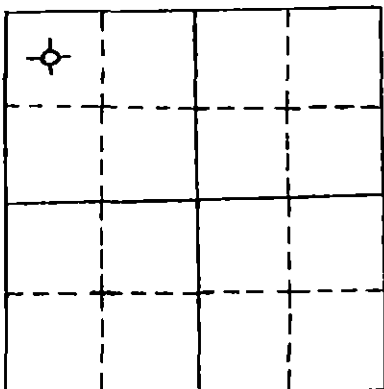

OIL, GAS OR WATER RECORDS

CASING RECORD

FORMATION	CONTENT	FROM	TO	SIZE	PUT IN	PULLED OUT
surface casing	common	0'	252.33	8 5/8	252.33	0'

Describe in detail the manner in which the well was plugged, indicating where the mud fluid was placed and the method or methods used in introducing it into the hold. If cement or other plugs were used, state the character of same and depth placed, from feet to feet for each plug set.

plug #1 cemented with 65 sxs @680'
plug #2 cemented with 30 sxs @ 270'
Plug #3 cemented with 10 sxs @ 40' solid bridge
5 sxs in rathole

total 110 sxs 50-50 Poz 4% gel

CONSERVATION DIVISION
Wichita, Kansas

(If additional description is necessary, use BACK of this sheet)

Name of Plugging Contractor Pioneer Drilling Company, Inc.
308 West Mill Plainville, KS 67663


STATE OF Kansas COUNTY OF Rooks, ss.

Connie Jo Austin (employee of owner) or (owner or operator) of the above described well, being first duly sworn on oath, says: That I have knowledge of the facts, statements, and matters herein contained and the log of the above described well is filed and that the same are true and correct. So help me God.

(Signature) Connie Jo Austin
(Address) 308 W mill Plainville, Ks. 67663

SUBSCRIBED AND SWORN TO before me this 26th day of March, 19 81

My commission expires

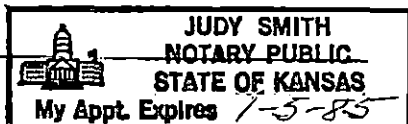

Judy Smith
Notary Public