


STATE OF KANSAS
STATE CORPORATION COMMISSION

WELL PLUGGING RECORD

Give All Information Completely
Make Required Affidavit
Mail or Deliver Report to
Conservation Division
State Corporation Comm.
245 North Water
Wichita, KS 67202

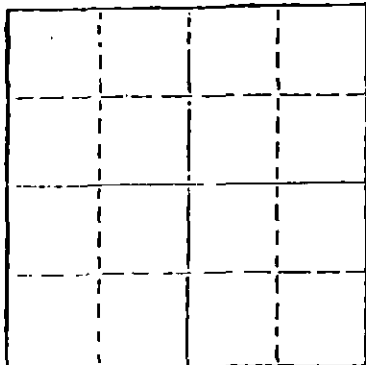

Locate well correctly on above
Section Plat

Pawnee County, Sec. 10 Twp. 20 Rge. 20 E/W
Location as "NE/CNW $\frac{1}{2}$ SW $\frac{1}{2}$ " or footage from lines
990' SFNL 115' WFEL C-S/2 NE SW
Lease Owner George Reed
Lease Name Lanterman Well No. 1
Office Address 535 Fourth Financial Center Wichita, Kans.
Character of Well (Completed as Oil, Gas or Dry Hole)
Dry Hole
Date Well completed January 18 1980
Application for plugging filed January 18 1980
Application for plugging approved January 18 1980
Plugging commenced 1:00 A.M. January 18 1980
Plugging completed 2:00 A.M. January 18 1980
Reason for abandonment of well or producing formation

If a producing well is abandoned, date of last production 19

Was permission obtained from the Conservation Division or its agents before plugging was commenced? yes

Name of Conservation Agent who supervised plugging of this well Marion Schmidt
Producing formation Depth to top Bottom Total Depth of Well 4350'
Show depth and thickness of all water, oil and gas formations.

OIL, GAS OR WATER RECORDS

CASING RECORD

FORMATION	CONTENT	FROM	TO	SIZE	PUT IN	PULLED OUT

Describe in detail the manner in which the well was plugged, indicating where the mud fluid was placed and the method or methods used in introducing it into the hold. If cement or other plugs were used, state the character of same and depth placed, from feet to feet for each plug set.

630' with 60 sx. 50/50 Pozmix, 4% Gel.
450' with 30 sx. 50/50 Pozmix, 4% Gel.
40' with 10 sx. 50/50 Pozmix, 4% Gel.

(If additional description is necessary, use BACK of this sheet)

Name of Plugging Contractor

STATE OF Kansas COUNTY OF Barton
Don Popp (employee of owner) or (owner/operator)

of the above-described well, being first duly sworn on oath, says: That I have knowledge of the facts, statements, and matters herein contained and the log of the above-described well as filed and that the same are true and correct. So help me God.

(Signature)

Don Popp, Noisington, Kansas

(Address)

SUBSCRIBED AND SWORN TO before me this 18th day of January, 1980.

Bessie M. Dewerff, Notary Public.

My commission expires 5-20-81

BESSIE M. DEWERFF
STATE NOTARY PUBLIC
BARTON COUNTY, KANSAS
MY APPT. EXP. 5-20-81

DRILLERS WELL LOG

L. D. Drilling Company - Contractor

George Reed - Operator

LANTERMAN # 1
C-S/2-NE-SW
Sec. 10-20-20
PAWNEE COUNTY, KANS.

T. D. 4350'
ELEV. 2230 K.B.

COMMENCED: 1-9-80
COMPLETED: 1-18-80

CASING

8-5/8" set at 477'

CEMENT

W/275 sx. 50/50 Pozmix, 2% Gel, 3% CC

FORMATION

Rock
Shale
Shale & Red Bed
Shale
Anhydrite
Shale
Shale W/lime streaks
Shale W/lime
Lime & Shale
Lime
Lime & Shale
R.T.D.

DEPTH

0 - 132
132 - 725
725 - 1338
1338 - 1382
1382 - 1408
1408 - 2155
2155 - 2355
2355 - 3815
3815 - 3885
3885 - 4217
4217 - 4350
4350

TOPS

Anhy
Heebner
Toronto
Lansing
Base K/C
Ft. Scott
Cherokee
2nd Ck. sand
Cong. Chert
Mississippi
R.T.D.

1382
3689
3711
3738
4042
4178
4203
4265
4287
4303
4350

RECEIVED
STATE COMMISSION
JAN 24 1980
CONSERVATION DIVISION
Wichita, Kansas

AFFIDAVIT

State of Kansas County of Barton

I, Don Popp of the L. D. Drilling Company

being first duly sworn on oath, State: That I have knowledge of the facts statements and matters herein contained and that the same are true and correct.

Don Popp
Don Popp

Subscribed and sworn to before me on this 21st day of January 1980

My commission expires: 5-20-81

Bessie M. DeWerff
Notary Public: Bessie M. DeWerff

BESSIE M. DEWERFF
STATE NOTARY PUBLIC
BARTON COUNTY, KANSAS
MY A. EXP. 5-20-81