


WELL PLUGGING RECORD

Give All Information Completely
Make Required Affidavit
Mail or Deliver Report to:
Conservation Division
State Corporation Commission
800 Bittling Building
Wichita, Kansas

NORTH

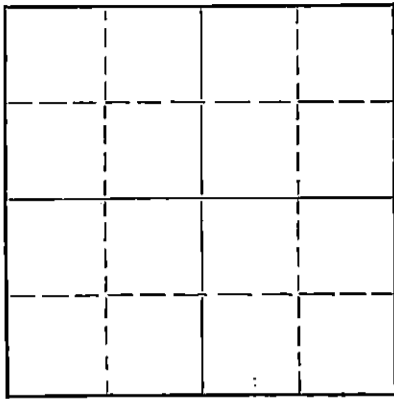

Locate well correctly on above Section Plat

Pawnee County. Sec. 12 Twp. 20 Rge. 20 (E) W. (W)
Location as "NE/CNW/SW" or footage from lines 330' N. & 330' W. of SE Cor.
Lease Owner Cities Service Oil Company
Lease Name Jennings Well No. 2
Office Address Great Bend, Kansas
Character of Well (completed as Oil, Gas or Dry Hole) Oil Well
Date well completed January 1, 19 55
Application for plugging filed February 8, 19 56
Application for plugging approved February 9, 19 56
Plugging commenced March 12, 19 56
Plugging completed March 16, 19 56
Reason for abandonment of well or producing formation Depleted Formation

If a producing well is abandoned, date of last production December 28, 19 55
Was permission obtained from the Conservation Division or its agents before plugging was commenced? Yes

Name of Conservation Agent who supervised plugging of this well R. M. Brundage
Producing formation Mississippi Depth to top 4286 Bottom 4304 Total Depth of Well 4304 Feet
Show depth and thickness of all water, oil and gas formations. P. B. T. D. 4285

OIL, GAS OR WATER RECORDS

CASING RECORD

FORMATION	CONTENT	FROM	TO	SIZE	PUT IN	PULLED OUT
				8-5/8"	503'	None
				5-1/2"	4304'	2240'

Describe in detail the manner in which the well was plugged, indicating where the mud fluid was placed and the method or methods used in introducing it into the hole. If cement or other plugs were used, state the character of same and depth placed, from _____ feet to _____ feet for each plug set.

4285-4210', river sand.
4210-4170', 5 sacks cement.
4170-350', mud.
350-275', rock bridge and 20 sacks cement.
275-45', mud.
45' to base of cellar, rock bridge and 10 sacks cement.

(If additional description is necessary, use BACK of this sheet)

Name of Plugging Contractor Wilson, Inc. - Chas. D. Wilson, Operator
Address 2921 Bonita, Great Bend, Kansas

STATE OF Kansas, COUNTY OF Barton, ss.
V. M. Conover (employee of owner) or ~~owner or operator~~ of the above-described well, being first duly sworn on oath, says: That I have knowledge of the facts, statements, and matters herein contained and the log of the above-described well as filed and that the same are true and correct. So help me God.

(Signature) V. M. Conover
Box 751, Great Bend, Kansas
(Address)

SUBSCRIBED AND SWORN TO before me this 26th day of March, 19 56

My commission expires March 12, 1959.

24-7368-5 3-53-20M

RECEIVED Notary Public.
STATE CORPORATION COMMISSION

MAR 27 1956

CONSERVATION DIVISION
Wichita, Kansas

3-28-1956

PLUGGING
FILE REC 12 T 20 R 20W
BOOK PAGE 37 LINE 31

WELL RECORD

15.45-01356-0000

Company Cities Service Oil Co. Well No. 2 Farm Jennings
 Location 330' North and 330' West of SE Cor. Sec. 12 T. 20 R. 20W
 Elevation 2215 (2212 Cr.) County Pawnee State Kansas
 Drlg. Comm. December 15, 1954 Contractor Brack Drilling Company
 Drlg. Comp. January 1, 1955 Acid None
 T. D. 4304' Initial Prod. Physical Potential: 18 oil, 1.2% water, 24 hours (1-21-55)
 P. B. T. D. 4235'

CASING RECORD:

8-5/8" @ 503' con. 300 sacks cement
 5-1/2" @ 4304' con. 125 sacks cement

FORMATION RECORD:

clay	0-45
shale & shells	360
sand	390
shale	503
red bed	785
sand	1040
shale & red bed	1251
anhydrite	1385
red bed & shale	1810
shale & shells	2130
lime & shale	2625
lime	2635
lime & shale	2900
shale	3235
lime & shale	3453
lime	3565
lime & shale	3597
shale & lime	3635
lime & shale	3780
lime	4070
lime & shale	4139
lime	4208
shale & sand	4241
shale & lime	4257
shale & sand	4305

4305 RTD = 4304 SLM

Corr. Heebner	3560'
Corr. Hedge	3680'
Corr. Lansing	3707'
Corr. Base Kansas City	4018'
Corr. Cherokee	4140'
Corr. Base Penn. Sand	4199'
Corr. Mississippi	4286'
Penetration	18'
Total Depth	4304'

Drilled cement to 4285 S. L. M.

Perf. 21 shots 4217-23.
 Perf. 26 shots 4225-30.

125' oil in 35 mins.
 505' oil in 3 hrs. 5 mins.

SLOPE TESTS (SURE SHOT):

500'	1°
1000'	1/2°
1500'	3/4°
2000'	1/4°
2500'	3/4°
3000'	3/4°
3500'	1°
4000'	1°

PLUGGING
 FILE SEC 12 T 20 R 20W
 BOOK PAGE 37 LINE 31

