


STATE OF KANSAS  
STATE CORPORATION COMMISSION

Form CP-4

Give All Information Completely  
Make Required Affidavit  
Mail or Deliver Report to:  
Conservation Division  
State Corporation Commission  
212 No. Market  
Wichita, Kansas

WELL PLUGGING RECORD

NORTH

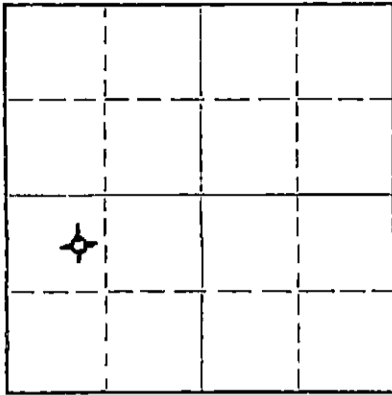

Locate well correctly on above  
Section Plat

Pawnee County, Sec. 13 Twp. 20S Rge. 20 (W)

Location as "NE/CNW/SW" or footage from lines C E/2 NW/4 SW/4

Lease Owner Alco Oil and Gas Corporation

Lease Name Jennings "B" Well No. 1

Office Address P. O. Box 52027, Lafayette, Louisiana 70501

Character of Well (completed as Oil, Gas or Dry Hole) Dry Hole

Date well completed 1-29 19 68

Application for plugging filed " 19 "

Application for plugging approved " 19 "

Plugging commenced " 19 "

Plugging completed " 19 "

Reason for abandonment of well or producing formation Dry Hole

If a producing well is abandoned, date of last production 19

Was permission obtained from the Conservation Division or its agents before plugging was commenced? Yes

Name of Conservation Agent who supervised plugging of this well Leo Massey

Producing formation \_\_\_\_\_ Depth to top \_\_\_\_\_ Bottom \_\_\_\_\_ Total Depth of Well \_\_\_\_\_ Feet

Show depth and thickness of all water, oil and gas formations.

OIL, GAS OR WATER RECORDS

CASING RECORD

FORMATION	CONTENT	FROM	TO	SIZE	PUT IN	PULLED OUT
					<u>517'</u>	<u>None</u>
	<b>RECEIVED</b>					
	STATE CORPORATION COMMISSION					
	<b>FEB 12 1968</b>					
	CONSERVATION DIVISION					
	Wichita, Kansas					

Describe in detail the manner in which the well was plugged, indicating where the mud fluid was placed and the method or methods used in introducing it into the hole. If cement or other plugs were used, state the character of same and depth placed, from \_\_\_\_\_ feet to \_\_\_\_\_ feet for each plug set.

4342 - 660' - Heavy rotary mud  
660' - HB plug, 70 sacks cement  
660 - 40' - Heavy rotary mud  
40 - GL - HB plug, 10 sacks Halco Posmex with 6% Gel

Plugged with Halliburton equipment.

RECEIVED

FEB 7 1968

ALCO OIL AND GAS CORPORATION

2-7-1968

(If additional description is necessary, use BACK of this sheet)

Name of Plugging Contractor Peel Brothers, Inc.

Address Box 359, Hoisington, Kansas 67544

STATE OF Kansas, COUNTY OF Barton, ss.  
Peel Brothers, Inc. (employee of owner) of the above-described

well, being first duly sworn on oath, says: That I have knowledge of the facts, statements, and matters herein contained and the log of the above-described well as filed and that the same are true and correct. So help me God. PEEL BROTHERS, INC.

(Signature) Wendell C. Peel

Wendell C. Peel, President

(Address)

SUBSCRIBED AND SWORN TO before me this 2nd day of February, 19 68

My commission expires 6-21-70

Ethel S. Williamson  
Ethel S. Williamson Notary Public.

ALCO  
FEB - 4 '68  
GREAT BEND, KS.