


STATE OF KANSAS
STATE CORPORATION COMMISSION

Give All Information Completely
Make Required Affidavit
Mail or Deliver Report to:
Conservation Division
State Corporation Commission
211 N. Broadway
Wichita, Kansas

WELL PLUGGING RECORD

NORTH

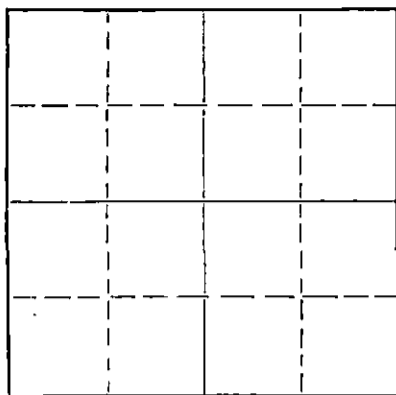

Locate well correctly on above Section Plat

Pawnee County, Sec. 13 Twp. 20 Rge. 20 (E) W. (W)
Location as "NE/CNW/SW" or footage from lines 1650' FSL, 2310' FHL
Lease Owner Cities Service Oil Company
Lease Name Hagerman "B" Well No. 1
Office Address Box 308, Great Bend, Kansas
Character of Well (completed as Oil, Gas or Dry Hole) Dry Hole
Date well completed October 6 19 65
Application for plugging filed October 6 19 65
Application for plugging approved October 6 19 65
Plugging commenced October 6 19 65
Plugging completed October 6 19 65
Reason for abandonment of well or producing formation Dry Hole

If a producing well is abandoned, date of last production _____ 19____
Was permission obtained from the Conservation Division or its agents before plugging was commenced? Yes

Name of Conservation Agent who supervised plugging of this well Eldon Petty
Producing formation _____ Depth to top _____ Bottom _____ Total Depth of Well 4324 Feet
Show depth and thickness of all water, oil and gas formations.

OIL, GAS OR WATER RECORDS

CASING RECORD

FORMATION	CONTENT	FROM	TO	SIZE	PUT IN	PULLED OUT
				8-5/8"	518'	None

Describe in detail the manner in which the well was plugged, indicating where the mud fluid was placed and the method or methods used in introducing it into the hole. If cement or other plugs were used, state the character of same and depth placed, from _____ feet to _____ feet for each plug set.

4324-510', heavy mud with plug at 510'.
510- 240', 20 sx cement with plug at 240'.
240- 40', 20 sx cement with 1/2 sx hulls and plug at 40'.
40' to base of cellar, 10 sx cement.

RECEIVED
STATE CORPORATION COMMISSION

OCT 13 1965

CONSERVATION DIVISION
Wichita, Kansas

(If additional description is necessary, use BACK of this sheet)

Name of Plugging Contractor Peel Brothers, Inc.
Address Hoisington, Kansas

STATE OF Kansas, COUNTY OF Barton, ss.
W. J. Devaney (employee of owner) of the above-described well, being first duly sworn on oath, says: That I have knowledge of the facts, statements, and matters herein contained and the log of the above-described well as filed and that the same are true and correct. So help me God.

(Signature) [Signature]
Box 308, Great Bend, Kansas
(Address)

SUBSCRIBED AND SWORN TO before me this 11th day of October 19 65

My commission expires Dec. 6, 1966. [Signature] Notary Public.

15.145.30084.0000

WELL RECORD

WILDCAT.....

DISCOVERY.....

POOL.....

Company Cities Service Oil Company Well No. 1 Farm Hagerman "B"

Location 1650' from S.L. & 2310' from E.L. Sec. 13 T. 20S R. 20W

Elev. Serv. K.B. 2204' D.F. 2201' Gr. 2197' Co. Pawnee State Kansas

Dry Hole

N. I. P. P. & A. 10/6/65 A. I. P. _____ Grav. _____

Pay Zones.....

Perforations.....

Acid None Hydrafrac.....

T. D. 4326' P. B. T. D. _____ N. T. D. _____ Drlg. Comm. 9/24/65 Drlg. Comp. 10/6/65

CASING RECORD:

8 5/8" @ 518' w/275 sax. cem.

Contractor Peel Brothers, Inc.

Formation Record:

Formation	Depth:
clay & limestone	0 - 70
shale & shells	527
shale	585
shale & shells	780
sand	985
shale & red bed	1350
anhydrite	1380
shale & shells	2150
lime & shale	2417
lime	2505
lime & shale	2630
lime	2761
lime & shale	2980
shale & lime	3127
lime & shale	3505
shale & lime	3610
lime & shale	3695
lime	4135
lime & shale	4270
shale & lime	4304
lime	4315
lime, shale & chert	4324 RTD

Schlumberger Tops:

- Heebner 3665 (-1461)
- Toronto 3684 (-1480)
- Lansing 3713 (-1509)
- B.K.C. 4094 (-1888)
- Cherokee Sh. 4181 (-1977)
- Cherokee "B" Sd. 4213 (-2009)
- Cherokee "C" Sd. & Sdy. Cgl. 4238 (-2034)
- Cherokee "C" Sd. 4160 (-2056)
- Miss. 4306 (-2102)
- LTD 4326
- Pen. Miss. 20'

VJQ/ng
10/19/65

RECEIVED
STATE CORPORATION COMMISSION

NOV 30 1965

CONSERVATION DIVISION
Wichita, Kansas