


STATE OF KANSAS
STATE CORPORATION COMMISSION

WELL PLUGGING RECORD

Give All Information Completely
Make Required Affidavit
Mail or Deliver Report to
Conservation Division
State Corporation Comm.
245 North Water
Wichita, KS 67202

Pawnee County, Sec. 15 Twp. 20S Rge. 20W E/W
Location as "NE/CNW $\frac{1}{4}$ SW $\frac{1}{4}$ " or footage from lines
SE NW SW

Lease Owner Kansas Petroleum, Inc.
Lease Name Dick Well No. 1
Office Address 200 E. First, Suite 500, Wichita, KS 67202
Character of Well (Completed as Oil, Gas or Dry Hole) Dry Hole

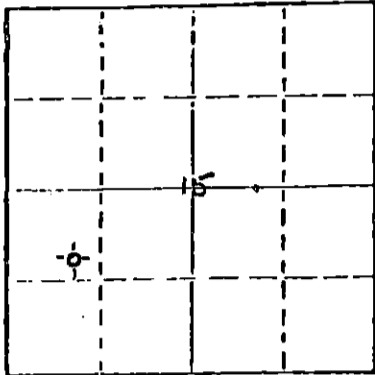

Locate well correctly on above
Section Plot

Date Well completed November 25 1980
Application for plugging filed November 25 1980
Application for plugging approved November 25 1980
Plugging commenced November 25 1980
Plugging completed November 25 1980
Reason for abandonment of well or producing formation

If a producing well is abandoned, date of last production 19

Was permission obtained from the Conservation Division or its agents before plugging was commenced? yes

Name of Conservation Agent who supervised plugging of this well Marion Schmidt
Producing formation Depth to top Bottom Total Depth of Well 4340
Show depth and thickness of all water, oil and gas formations.

OIL, GAS OR WATER RECORDS

CASING RECORD

FORMATION	CONTENT	FROM	TO	SIZE	PUT IN	PULLED OUT
Surface Hole	shale	surface	269	8-5/8	265	none
	Cemented with	200 sx	50/50	pozmix,	2% gel,	8% cc
		Plug down	@ 10:45	p.m.	11-18-80	by HOWCO.

Describe in detail the manner in which the well was plugged, indicating where the mud fluid was placed and the method or methods used in introducing it into the hold. If cement or other plugs were used, state the character of same and depth placed, from feet to feet for each plug set.

Plugged as follows w/110 sx 50/50 pozmix, 4% gel;

70 sx @ 680'

25 sx @ 240'

10 sx @ 40'

5 sx in rat hole

Marion Schmidt State Plugger; Job completed by HOWCO @ 12:45 -11-25-80

(If additional description is necessary, use BACK of this sheet)

Name of Plugging Contractor Husky Drilling Co., Inc.

DEC 4 1980
CONS. DIVISION
Wichita, Kansas

STATE OF KANSAS COUNTY OF SEDGWICK
Jon T. Williams, Jr. (employee of owner) or (owner or operator)

of the above-described well, being first duly sworn on oath, says: That I have knowledge of the facts, statements, and matters herein contained and the log of the above-described well as filed and that the same are true and correct. So help me God.

(Signature)

200 E. First, Suite 500, Wichita, KS 67202
(Address)

SUBSCRIBED AND SWORN TO before me this 1st day of December, 1980

Geraldine Stewart
Geraldine Stewart Notary Public.

My commission expires January 12, 1981

