


Give All Information Completely
Make Required Affidavit
Mail or Deliver Report to:
Conservation Division
State Corporation Commission
212 No. Market
Wichita, Kansas

WELL PLUGGING RECORD

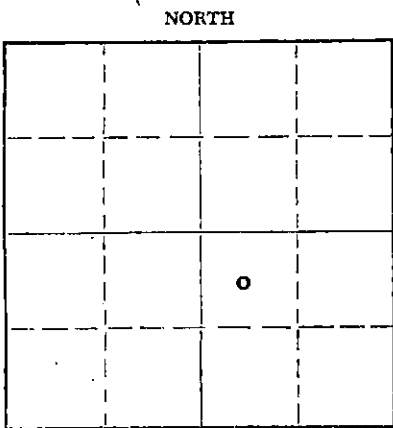

Locate well correctly on above
Section Plat

Pawnee County. Sec. 15 Twp. 20S Rge. 20W (E) (W)
Location as "NE/CNW/SW" or footage from lines C NW SE
Lease Owner Halliburton Oil Producing Co.
Lease Name Dick Well No. 1
Office Address 520 Cameron Bldg., Oklahoma City, Okla. 73106
Character of Well (completed as Oil, Gas or Dry Hole) Dry Hole
Date well completed April 12 19 69
Application for plugging filed April 12 19 69
Application for plugging approved April 12 19 69
Plugging commenced April 12 19 69
Plugging completed April 12 19 69
Reason for abandonment of well or producing formation Dry Hole

If a producing well is abandoned, date of last production _____ 19____
Was permission obtained from the Conservation Division or its agents before plugging was commenced? Yes

Name of Conservation Agent who supervised plugging of this well Eldon Petty, Hays, Kansas
Producing formation _____ Depth to top _____ Bottom _____ Total Depth of Well 4280 Feet
Show depth and thickness of all water, oil and gas formations.

OIL, GAS OR WATER RECORDS

CASING RECORD

FORMATION	CONTENT	FROM	TO	SIZE	PUT IN	PULLED OUT
		0	209'	8 5/8"	209'	None

Describe in detail the manner in which the well was plugged, indicating where the mud fluid was placed and the method or methods used in introducing it into the hole. If cement or other plugs were used, state the character of same and depth placed, from _____ feet to _____ feet for each plug set.

Plug: 660'/70 sacks cement
180'/20 sacks cement
40'/10 sacks cement

RECEIVED
STATE CORPORATION COMMISSION
APR 21 1969
CONSERVATION DIVISION
Wichita, Kansas

(If additional description is necessary, use BACK of this sheet)
Name of Plugging Contractor Hellar Drilling Company, Inc.
Address 339 Union Center Bldg., Wichita, Kansas 67202

STATE OF Kansas COUNTY OF Sedgwick, ss.
D. L. Hellar, Pres. of Hellar Drilling Company, Inc. (employee of owner) or (owner or operator) of the above-described


well, being first duly sworn on oath, says: That I have knowledge of the facts, statements, and matters herein contained and the log of the above-described well as filed and that the same are true and correct. So help me God.

(Signature) D. L. Hellar D. L. Hellar, President
339 Union Center Bldg, Wichita, Kansas 67202
(Address)

SUBSCRIBED AND SWORN to before me this 18th day of April, 19 69

My commission expires March 25, 1972.

Catherine Darcey Notary Public.

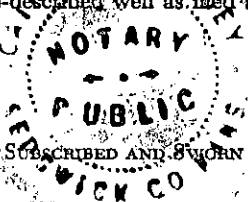

DRILLER'S LOG

COMPANY: Halliburton Oil Producing Co., Oklahoma City, Okla.
 CONTRACTOR: Hellar Drilling Company, Inc., Wichita, Kansas
 LEASE: #1 Dick
 LOCATION: C NW SE 15-20S-20W, Pawnee County, Kansas
 COMMENCED: April 5, 1969
 COMPLETED: April 12, 1969
 CASING: Set 8 5/8" Surface Casing @ 209'/175 sacks cement

0-100	Shale & Sand
100-211	Sand & Shale
211-1155	Shale-Red Bed-Shells & Sand
1155-1352	Shale
1352-1378	Anhydrite
1378-2050	Shale
2050-2280	Salt Section & Cherty Lime
2280-2423	Ft. Riley - Chert & Lime
2423-3810	Lime & Shale
3810-3902	Lime & Shale breaks
3902-4280	Lime & Shale
4280	Rotary Total Depth

RECEIVED
 STATE CORPORATION COMMISSION
 APR 21 1969
 CONSERVATION DIVISION
 Wichita, Kansas

D & A

STATE OF KANSAS)
) SS
 COUNTY OF SEDGWICK)

I, D. L. Hellar, do hereby certify that the above and foregoing is a true and correct copy of the log of the #1 Dick, located in C NW SE 15-20S-20W, Pawnee County, Kansas, as reflected by the files of the Hellar Drilling Company, Inc.

HELLAR DRILLING COMPANY, INC.

By *D. L. Hellar*
 President - D. L. Hellar

Subscribed and sworn to before me, a Notary Public, in and for Sedgwick County, Kansas, this 18th day of April, 1969.



Catherine Darcey
 Notary Public - Catherine Darcey

My Commission Expires: March 25, 1972.