

WELL PLUGGING RECORD

Give All Information Completely
Make Required Affidavit
Mail or Deliver Report to:
Conservation Division
State Corporation Commission
211 No. Broadway
Wichita, Kansas

Pawnee County. Sec. 14 Twp 20S Rge. 20W (XX) (W)

Location as "NE/CNW%SW%" or footage from lines SE SE SW

Lease Owner D. R. Lauck Oil Company, Inc. and Nadel & Gussman

Lease Name Risse Well No. 1

Office Address 301 S. Broadway, Wichita, Kansas

Character of Well (completed as Oil, Gas or Dry Hole) Dry Hole

Date well completed October 6, 1964

Application for plugging filed October 6, 1964

Application for plugging approved October 6, 1964


Plugging commenced October 6, 1964

Plugging completed October 6, 1964

Reason for abandonment of well or producing formation Dry Hole

If a producing well is abandoned, date of last production _____ 19__

Was permission obtained from the Conservation Division or its agents before plugging was commenced? Yes

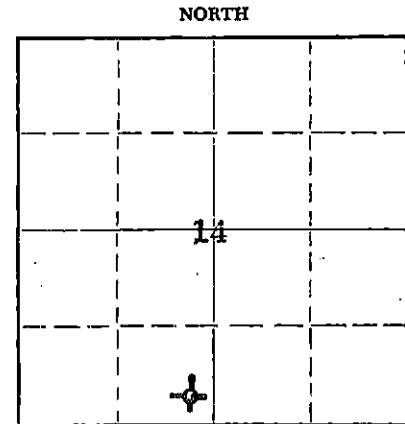

Locate well correctly on above Section Plat

Name of Conservation Agent who supervised plugging of this well Eldon Petty

Producing formation _____ Depth to top _____ Bottom _____ Total Depth of Well 4272 Feet

Show depth and thickness of all water, oil and gas formations.

OIL, GAS OR WATER RECORDS

CASING RECORD

FORMATION	CONTENT	FROM	TO	SIZE	PUT IN	PULLED OUT
	<u>8x</u>	<u>0'</u>	<u>318'</u>	<u>8-5/8"</u>	<u>318'</u>	<u>None</u>

Describe in detail the manner in which the well was plugged, indicating where the mud fluid was placed and the method or methods used in introducing it into the hole. If cement or other plugs were used, state the character of same and depth placed, from _____ feet to _____ feet for each plug set.

- 4272'-540' Mud
- 540'-536' Plug
- 536'-496' Cement, 20 sacks
- 496'-240' Mud
- 240'-236' Plug
- 236'-196' Cement, 20 sacks
- 196'- 40' Mud
- 40'- 36' Plug
- 36'- 6' Cement, 10 sacks (Bottom of Cellar)

RECEIVED
STATE CORPORATION COMMISSION

OCT 12 1964

CONSERVATION DIVISION
Wichita, Kansas

(If additional description is necessary, use BACK of this sheet)

Name of Plugging Contractor Globe Cementing Co.
Address Great Bend, Kansas

10-12-1964

STATE OF KANSAS, COUNTY OF SEDGWICK, ss.
John H. Knightley (employee of owner) or (owner or operator) of the above-described

well, being first duly sworn on oath, says: That I have knowledge of the facts, statements, and matters herein contained and the log of the above-described well as filed and that the same are true and correct. So help me God.

(Signature) John H. Knightley
301 S. Broadway, Wichita, Kansas
(Address)

SUBSCRIBED AND SWORN TO before me this 9th day of October, 1964

Stella J. Papp
Notary Public.

My commission expires March 12, 1967

D. R. Lauck Oil Company, Inc. and
Nadel & Gussman

Risse #1

SE SE SW Sec. 14-20S-20W
Pawnee County, Kansas

Commenced: September 23, 1964
Completed: October 6, 1964

Casing Record: 318' 8-5/8" Cemented with 200 sacks Cement,
4 sacks Calcium Chloride.

Elevation: 2198 GL; 2200 DF; 2202 KB.

Drillers Log

Tops

Sand & Shale	314
Shale & Sand	600
Shale & Red Bed	1335
Anhydrite	1365
Shale & Lime	1444
Shale & Red Bed	1900
Shale	2208
Shale & Lime	2525
Lime & Shale	2600
Shale & Lime	2793
Lime & Shale	2886
Shale & Lime	2988
Shale & Lime	3605
Lime & Shale	3800
Shale & Lime	3840
Lime & Shale	3917
Lime	4034
Lime & Shale	4198
Shale & Lime	4243
Lime, Shale, Chert	4260
Lime	4272 RTD

	Sample	Welex
Heebner	3644-1442	3639-1437
Lansing	3695-1493	3699-1497
Base Kansas City	4070-1868	4070-1868
Cherokee Shale	4157-1955	4157-1955
Cherokee Sand	4172-1970	4172-1970
Mississippian	4253-2051	4253-2051
Total Depth	4272-2070	4272-2070

DST #1 (M) 4210-4260, open 20 minutes,
weak blow 20 minutes. Recovered
15' mud. No ISIP taken. FSIP
920# still climbing 10 min.
IFP 70#. FFP 85#.

DST #2, (M) 4260-4272, open 90 minutes,
weak blow 90 minutes. Recovered
5' clean oil, 120' muddy water.
ISIP 1340#/30 min. FSIP 1092#/30
min. IFP 47#. FFP 105#.

Straddle DST, 4150-4179, (Welex 4152-91)
Open 15 minutes, weak blow 8 min.
Recovered 3' mud. No ISIP taken.
FSIP 31#/10 min. IFP 31#. FFP 31#.

I hereby certify that this is a true and correct
log of the above mentioned well, to the best
of my knowledge and belief.

D&A

John H. Knightley
Subscribed and sworn to before me this

9th day of October, 1964.

Stella J. Lipp
Notary Public

My commission expires 3-12-67

RECEIVED
STATE CORPORATION COMMISSION

OCT 12 1964

CONSERVATION DIVISION
Wichita, Kansas

