


Give All Information Completely
Make Required Affidavit
Mail or Deliver Report to:
Conservation Division
State Corporation Commission
211 No. Broadway
Wichita, Kansas

WELL PLUGGING RECORD

NORTH

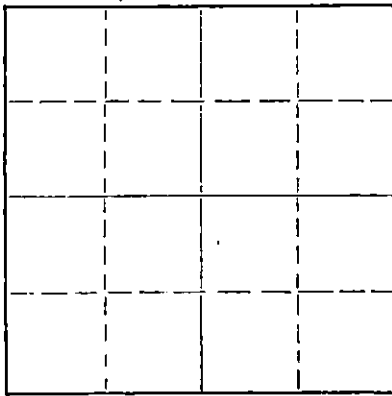

Locate well correctly on above
Section Plat

Pawnee County. Sec. 14 Twp. 20 Rge. 20 (E) W. (W)
Location as "NE/CNW/SW" or footage from lines 975' S., 982' W. of NE Cor.
Lease Owner Cities Service Oil Company
Lease Name Risse "A" Well No. 2
Office Address Box 308, Great Bend, Kansas
Character of Well (completed as Oil, Gas or Dry Hole) Oil Well
Date well completed April 12 19 54
Application for plugging filed January 6 19 66
Application for plugging approved January 10 19 66
Plugging commenced February 26 19 66
Plugging completed March 1 19 66
Reason for abandonment of well or producing formation Depleted.

If a producing well is abandoned, date of last production January 13 19 66
Was permission obtained from the Conservation Division or its agents before plugging was commenced? Yes

Name of Conservation Agent who supervised plugging of this well Gilbert Leiker
Producing formation Basal Penn. Depth to top 4180 Bottom 4192 Total Depth of Well 4267 Feet
Show depth and thickness of all water, oil and gas formations.

OIL, GAS OR WATER RECORDS

CASING RECORD

FORMATION	CONTENT	FROM	TO	SIZE	PUT IN	PULLED OUT
				8-5/8"	506'	None
				5-1/2"	4287'	2632'

Describe in detail the manner in which the well was plugged, indicating where the mud fluid was placed and the method or methods used in introducing it into the hole. If cement or other plugs were used, state the character of same and depth placed, from _____ feet to _____ feet for each plug set.

4267-4160', sand, 5 sx cement.
4160- 480', mud, rock bridge, 5 sx cement.
480- 420', 20 sx cement.
420- 200', mud.
200- 140', 20 sx cement.
140- 40', mud.
40' - base cellar, 10 sx cement.

RECEIVED
STATE CORPORATION COMMISSION

MAR 15 1966

CONSERVATION DIVISION
Wichita, Kansas

(If additional description is necessary, use BACK of this sheet)

Name of Plugging Contractor Knight Casing Pulling Co.
Address Chase, Kansas

STATE OF Kansas, COUNTY OF Barton, ss.
W. J. Devaney (employee of owner) or ~~owner or operator~~ of the above-described well, being first duly sworn on oath, says: That I have knowledge of the facts, statements, and matters herein contained and the log of the above-described well as filed and that the same are true and correct. So help me God.

(Signature) *W. J. Devaney*
Box 308, Great Bend, Kansas
(Address)

SUBSCRIBED AND SWORN TO before me this 10th day of March, 19 66

W. M. McFarland
Notary Public.

My commission expires Dec. 6, 1966

WELL RECORD

15.145.01393.0000

Company Cities Service Oil Company Well No. 2 Farm Miss "A"
 Location 975' South and 932' West of NE Corner Sec. 14 T. 20 R. 20W
 Elevation 2182 (2180 Cr.) County Farmco State Kansas
 Drlg. Comm. March 27, 1954 Contractor Ben F. Brack Oil Co., Inc.
 Drlg. Comp. April 12, 1954 Acid None
 T.D. 4287' Initial Prod. Physical Potential: 488 oil, no water, 24 hrs. (4-27-54)
 P.B.T.D. 4267'

CASING RECORD:

8-5/8" @ 506' cas. 300 wt cement
 5-1/2" @ 4287' cas. 150 wt cement

FORMATION RECORD:

clay & sand	0-75
shale & shells	350
shale & sand	460
shale & shells	506
shale	550
red bed & shale	755
sand	960
red bed & shale	1280
red bed	1330
anhydrite	1360
shale	1951
lime & shale	2125
broken lime & shale	2225
lime	2310
lime & shale	2430
lime	2505
lime & shale	2790
shale	2905
broken lime & shale	3020
lime & shale	3507
lime	4130
sand & lime	4167
lime & sand	4193
lime, chert & sand	4229
sand & shale	4260
shale, sand & chert	4285

4285 ITD = 4267 SIN

Corr. Heebner	3634'
Corr. Dodge	3654'
Corr. Lansing	3685'
Corr. Basal Penn. Sand	4182'
Corr. Cherty Congl.	4255'
Corr. Mississippi	4273'
Penetration	14'
Total Depth	4287'

Drilled cement to 4267 S. L. M.

Perf. 41 shots 4180-92

2652' oil in 2 hrs. 10 mins.
 3127' oil in 3 hrs. 40 mins.

SLOPE TESTS (TOYCO):	500'	1-3/4°
	1000'	1/2°
	1500'	1/2°
	2000'	3/4°
	2500'	3/4°
	3000'	3/4°
	3500'	1°

STATE OF KANSAS
 CONSERVATION DIVISION
 Wichita, Kansas
 JAN 10 1966