


WELL PLUGGING RECORD

Give All Information Completely  
Make Required Affidavit  
Mail or Deliver Report to:  
Conservation Division  
State Corporation Commission  
211 No. Broadway  
Wichita, Kansas

Pawnee County, Sec. 17 Twp. 20 Rge. 20 (E) W (W)

Location as "NE/CNW&SW¼" or footage from lines SW SW NE  
Lease Owner Morgenstern Oil Operations  
Lease Name Wagner Well No. 1  
Office Address Wichita, Kansas  
Character of Well (completed as Oil, Gas or Dry Hole) \_\_\_\_\_  
Date well completed \_\_\_\_\_ 19\_\_\_\_  
Application for plugging filed \_\_\_\_\_ 19\_\_\_\_  
Application for plugging approved \_\_\_\_\_ 19\_\_\_\_  
Plugging commenced 9-28-61 \_\_\_\_\_ 19\_\_\_\_  
Plugging completed 10-3-61 \_\_\_\_\_ 19\_\_\_\_  
Reason for abandonment of well or producing formation Depleted.

NORTH

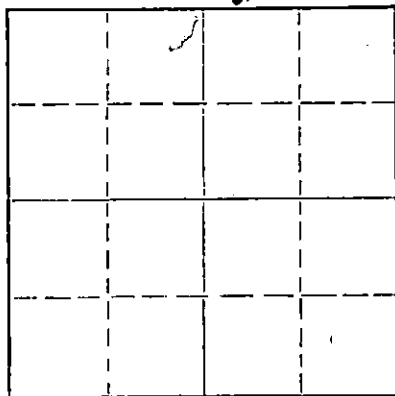

Locate well correctly on above Section Plat

If a producing well is abandoned, date of last production \_\_\_\_\_ 19\_\_\_\_  
Was permission obtained from the Conservation Division or its agents before plugging was commenced? yes

Name of Conservation Agent who supervised plugging of this well Fred Hample  
Producing formation \_\_\_\_\_ Depth to top \_\_\_\_\_ Bottom \_\_\_\_\_ Total Depth of Well 4339 Feet  
Show depth and thickness of all water, oil and gas formations.

OIL, GAS OR WATER RECORDS

CASING RECORD

FORMATION	CONTENT	FROM	TO	SIZE	PUT IN	PULLED OUT
				8-5/8"	481 1/2'	None
				5-1/2"	4338'	3533'

Describe in detail the manner in which the well was plugged, indicating where the mud fluid was placed and the method or methods used in introducing it into the hole. If cement or other plugs were used, state the character of same and depth placed, from \_\_\_\_\_ feet to \_\_\_\_\_ feet for each plug set.

Checked hole to 4339', ran sand to 4200'

and dumped 5 sacksof cement @ 4200' with dump bailer. Pulled 5 1/2" casing and pumped in 15 sacks of jall mud and 75 sacks of cement for top plug.

PLUGGING COMPLETE.

RECEIVED  
STATE CORPORATION COMMISSION

OCT 16 1961

CONSERVATION DIVISION

10-16-1961

(If additional description is necessary, use BACK of this sheet)  
Name of Plugging Contractor Knight Casing Pulling Company  
Address Chase, Kansas

STATE OF Kansas, COUNTY OF Rice, ss.  
Noel J. Knight (employee of owner) or (~~owner or lessee~~) of the above-described well, being first duly sworn on oath, says: That I have knowledge of the facts, statements, and matters herein contained and the log of the above-described well as filed and that the same are true and correct. So help me God.

(Signature) Noel J. Knight  
Chase, Kansas  
(Address)

SUBSCRIBED AND SWORN TO before me this 5th day of October, 1961

My commission expires May 20, 1964

Milton J. Volin  
Notary Public.



WELL LOG BUREAU—KANSAS GEOLOGICAL SOCIETY  
508 East Murdock, Wichita, Kansas


15.145.01357.0000 COPY

Company- NATURAL GAS & OIL CORP.  
Farm- Wagner No. 1

SEC. 17 T. 20 R. 20W  
SW SW NE

Total Depth. 4339'  
Comm. 12-3-57 Comp. 12-17-57  
Shot or Treated.  
Contractor. Strata Drlg. Inc.  
Issued. 4-12-58

County Pawnee  
KANSAS

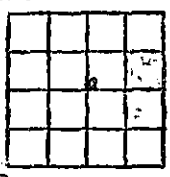

CASING:  
8 5/8" 481 1/2' w/200 sx cem.  
5 1/2" 4338' w/100 sx cem.

Elevation. 2183' DF

Production. 76 BOPD 4 10% wtr.

Figures indicate Bottom of Formations.

surface soils, shale	70
shale	250
sand	300
shale	560
red bed	670
"nhydrite	700
shale, shells	2250
lime	2580
lime, shale	3350
lime	4339 RTD
Total Depth	

TOPS:

Heebner	3687
Lansing	3735
B/Kansas City	4044
Cherokee	4245
Mississippi Dolomite	4301
Mississippi chert	4314

DST #1 - 4316-4329, 1 hr 30 min.  
open, fair flow throuout test.  
Rec. 40' OCM, 290' muddy gassy oil  
Shut in-20 min. IFP 120#, FFP 180#,  
BHP 1200#.

DST #2 - 4239-39, open 30 mins.,  
weak blow 7 min., flushed tool,  
rec. 140' HO&GCM, SI 20 min.,  
FP 0, FBHP 1160#.

Drilled cement to 4335 1/2',  
20 perfs 4235-28, show of oil,  
25 " 4321-25  
25 " 4317-21  
500 gal mud acid, 550# max. pressure.

Ran Lane-Wells Radipactivity log.

3-9-48

**RECEIVED**  
STATE CORPORATION COMMISSION  
SEP. 27 1961  
CONSERVATION DIVISION  
Wichita, Kansas