


WELL PLUGGING RECORD

Give All Information Completely
Make Required Affidavit
Mail or Deliver Report to:
Conservation Division
State Corporation Commission
212 No. Market
Wichita, Kansas

Pawnee County, Sec. 17 Twp. 20 Rge. 20 (E) (W)

Location as "NE/CNW/SW" or footage from lines C NE NE
Lease Owner Rains & Williamson Oil Company
Lease Name Wagner Well No. 1
Office Address Wichita, Kansas
Character of Well (completed as Oil, Gas or Dry Hole)
Date well completed 19
Application for plugging filed 19
Application for plugging approved 19
Plugging commenced 1/16/68 19
Plugging completed 1/22/68 19
Reason for abandonment of well or producing formation depleted.

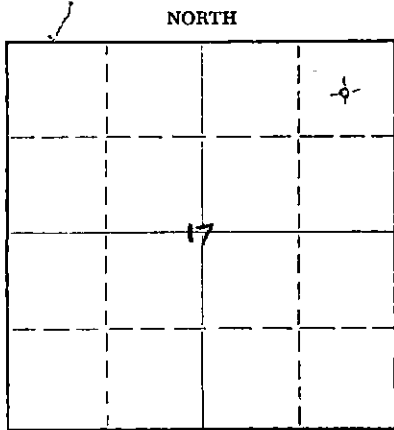

Locate well correctly on above Section Plat

If a producing well is abandoned, date of last production 19
Was permission obtained from the Conservation Division or its agents before plugging was commenced? yes

Name of Conservation Agent who supervised plugging of this well Massey
Producing formation Depth to top Bottom Total Depth of Well 4361 Feet
Show depth and thickness of all water, oil and gas formations.

OIL, GAS OR WATER RECORDS

CASING RECORD

FORMATION	CONTENT	FROM	TO	SIZE	PUT IN	PULLED OUT
				8-5/8"	299'	none
				5-1/2"	4357'	3207'

Describe in detail the manner in which the well was plugged, indicating where the mud fluid was placed and the method or methods used in introducing it into the hole. If cement or other plugs were used, state the character of same and depth placed, from feet to feet for each plug set.

Checked hole with bailer, pumped into pipe, pushed plug to 3500', ran 20' of sand and 5 sacks of cement. Shot pipe at 3380', 3276', and 3188', spotted oil, pumped 50 barrels oil, chased oil with plug to 3100', worked pipe loose and pulled 101 joints of 5 1/2" casing. Globe squeezed well, pumped 20 sacks mud, 4 hulls and 110 sacks of cement, 8 sacks of mud and 10 sacks of cement.

PLUGGING COMPLETE.

RECEIVED
STATE CORPORATION COMMISSION
JAN 25 1968
CONSERVATION DIVISION
Wichita, Kansas

(If additional description is necessary, use BACK of this sheet)

Name of Plugging Contractor KNIGHT CASING PULLING CO., INC.
Address CHASE, KANSAS

STATE OF KANSAS, COUNTY OF RICE, ss.
NOEL J. KNIGHT (employee of owner) or (owner or operator) of the above-described well, being first duly sworn on oath, says: That I have knowledge of the facts, statements, and matters herein contained and the log of the above-described well as filed and that the same are true and correct. So help me God.

(Signature) Noel Knight
CHASE, KANSAS (Address)

SUBSCRIBED AND SWORN TO before me this 23rd day of January, 1968

My commission expires February 15, 1971

Margaret Dredger
Notary Public.

15.145.20025.0000

ROTARY DRILLING LOG

Operator: Rains & Williamson Oil
Co., Inc.
#1 WAGNER
C NE NE Sec. 17-20S-20W
Pawnee County, Kansas

Contractor: Rains & Williamson Oil
Co., Inc.
Commenced: 9-15-67
Completed: 9-25-67 (Rotary)

Remarks: Set 8-5/8" surface
casing at 299.05' w/
175 sacks GL-3 cement.

Formations

Surface Soil	20'
Shale	315'
Shale and Red Bed	780'
Sand	990'
Shale and Red Bed	1348'
Anhydrite	1386'
Shale	2167'
Lime and Shale	2453'
Lime	2665'
Lime and Shale	2885'
Shale	3205'
Lime and Shale	3515'
Shale and Lime	3654'
Lime and Shale	3845'
Lime	4210'
Lime (Cherty)	4315'
Chert	4331'
Lime and Chert	4361'
Rotary Total Depth	4361'

RECEIVED
STATE CORPORATION COMMISSION
JAN 1 1 1968
CONSERVATION DIVISION
Wichita, Kansas

We certify the above log is true and
correct to the best of our knowledge
and belief.

RAINS & WILLIAMSON OIL CO., INC.

Wilson Rains

Wilson Rains

Subscribed and sworn to before me, a Notary Public within and for the State of
Kansas County of Sedgwick, this 29th day of September, 1967.

Sherry Gish

Sherry Gish Notary Public

My Commission Expires:
June 30, 1971

