


WELL PLUGGING RECORD

Give All Information Completely
Make Required Affidavit
Mail or Deliver Report to:
Conservation Division
State Corporation Commission
212 No. Market
Wichita, Kansas

Pawnee County. Sec. 17 Twp. 20S Rge. (E) 20 (W)
Location as "NE/CNW/SW" or footage from lines 100' E. of C NE NE
Lease Owner Rains & Williamson Oil Co., Inc.
Lease Name WAGNER Well No. 2
Office Address 1425 Wichita Plaza - Wichita, Kansas
Character of Well (completed as Oil, Gas or Dry Hole) Dry Hole
Date well completed 1-8 19 68
Application for plugging filed 1-8 19 68
Application for plugging approved 1-8 19 68
Plugging commenced 1-8 19 68
Plugging completed 1-8 19 68
Reason for abandonment of well or producing formation No oil or gas found in commercial quantities.
If a producing well is abandoned, date of last production None 19 --
Was permission obtained from the Conservation Division or its agents before plugging was commenced? Yes

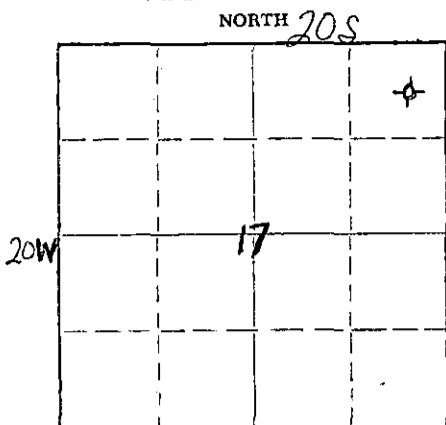

Locate well correctly on above Section Plat

Name of Conservation Agent who supervised plugging of this well Leo Massey, Hays, Kansas
Producing formation None Depth to top -- Bottom -- Total Depth of Well 4333 Feet
Show depth and thickness of all water, oil and gas formations.

OIL, GAS OR WATER RECORDS

CASING RECORD

FORMATION	CONTENT	FROM	TO	SIZE	PUT IN	PULLED OUT
				8-5/8"	285'	-0-

Describe in detail the manner in which the well was plugged, indicating where the mud fluid was placed and the method or methods used in introducing it into the hole. If cement or other plugs were used, state the character of same and depth placed, from _____ feet to _____ feet for each plug set.

Spotted 70 sacks 50-50 pozmix, 6% gel at 650'. Mud back to 270' and spotted 20 sacks. Mud back to 40', set solid bridge and capped with 10 sacks; 2 sacks in rat hole. Plugging completed at 7:15 A.M., 1-8-68.

RECEIVED
STATE CORPORATION COMMISSION
JAN 11 1968
CONSERVATION DIVISION
Wichita, Kansas

(If additional description is necessary, use BACK of this sheet)

Name of Plugging Contractor Rains & Williamson Oil Co., Inc.
Address 1425 Wichita Plaza - Wichita, Kansas

STATE OF KANSAS, COUNTY OF SEDGWICK, ss.
Wilson Rains (owner or operator) of the above-described

well, being first duly sworn on oath, says: That I have knowledge of the facts, statements, and matters herein contained and the log of the above-described well as filed and that the same are true and correct. So help me God.

(Signature) Wilson Rains Wilson Rains
1425 Wichita Plaza - Wichita, Kansas
(Address)

Subscribed and sworn to before me this 10 day of January, 19 68
Sherry Gish Notary Public.
My commission expires June 30, 1971



15.145.20042.0000

ROTARY DRILLING LOG

Operator: Rains & Williamson
Oil Co., Inc.
#2 WAGNER
100' East of C NE NE
Section 17-20S-20W
Pawnee County, Kansas

Contractor: Rains & Williamson
Oil Co., Inc.
Commenced: 12-30-67
Completed: 1-8-68
Remarks: Set 8-5/8" surface
casing at 285' w/
175 sacks GL-3.

Formations

Post Rock and Shale	44'
Shale	197'
Sand	212'
Shale and Sand	288'
Shale	692'
Anhydrite (Blaine)	700'
Shale and Red Bed	787'
Sand	992'
Shale and Red Bed	1278'
Red Bed	1357'
Anhydrite	1386'
Shale and Shells	1994'
Shale	2088'
Lime and Shale	2234'
Lime	2620'
Lime and Shale	3010'
Shale and Lime	3530'
Lime and Shale	3700'
Lime	4318'
Lime and Chert	4333'
Rotary Total Depth (D & A)	4333'

RECEIVED
STATE CORPORATION COMMISSION
JAN 1 1 1968
CONSERVATION DIVISION
Wichita, Kansas

We certify the above log is true and correct to the best of our knowledge and belief.

RAINS & WILLIAMSON OIL CO., INC.

Wilson Rains
Wilson Rains

Subscribed and sworn to before me, a Notary Public within and for the State of Kansas, County of Sedgwick, this 10th day of January, 1968.

Sherry Gish
Sherry Gish Notary Public

My Commission Expires:
June 30, 1971

