

STATE CORPORATION COMMISSION OF KANSAS
OIL & GAS CONSERVATION DIVISION

WELL COMPLETION OR RECOMPLETION FORM
ACO-1 WELL HISTORY

DESCRIPTION OF WELL AND LEASE

Operator: license # 7271
name Bartling Oil Company
address 8550 Katy Freeway
Suite 128
City/State/Zip Houston, Texas 77024

Operator Contact Person Carl S. Graef
Phone 713-465-1093

Contractor: license # 6033
name Murfin Drilling Co.

Wellsite Geologist Carl S. Graef
Phone 713-465-1093

PURCHASER

Designate Type of Completion
 New Well Re-Entry Workover

Oil SWD Temp Abd
 Gas Inj Delayed Comp
 Dry Other (Core, Water Supply etc.)

If OWWO: old well info as follows:

Operator
Well Name
Comp. Date Old Total Depth

WELL HISTORY

Drilling Method: Mud Rotary Air Rotary Cable
10-28-84 10-31-84 11-1-84
Spud Date Date Reached TD Completion Date

3196
Total Depth PBDT

Amount of Surface Pipe Set and Cemented at 291 feet

Multiple Stage Cementing Collar Used? Yes No

If Yes, Show Depth Set feet

If alternate 2 completion, cement circulated from feet depth to w/ SX cmt

API NO. 15 - 071-20,331-0000

County Greeley

Sec 24 Twp 20 Rge 41

4950 Ft North from Southeast Corner of Section
330 Ft West from Southeast Corner of Section
(Note: locate well in section plat below)


Lease Name Houston Well# 1

Field Name Wildcat

Producing Formation

Elevation: Ground 3625 KB 3630

Section Plat

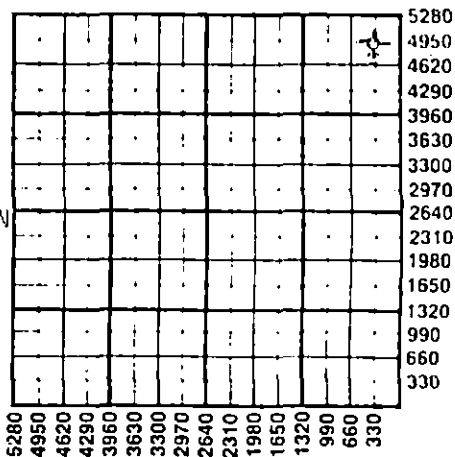

RECEIVED
NOV 07 1984
STATE CORPORATION COMMISSION
CONSERVATION DIVISION
Wichita, Kansas
11-7-84

WATER SUPPLY INFORMATION

Source of Water:

Division of Water Resources Permit #

Groundwater Ft North From Southeast Corner and
(Well) Ft. West From Southeast Corner
Sec Twp Rge East West

Surface Water Ft North From Southeast Corner and
(Stream, Pond etc.) Ft West From Southeast Corner
Sec Twp Rge East West

Other (explain) purchased from Daveco, Tribune, KS
(purchased from city, R.W.D.#)

Disposition of Produced Water: Disposal Repressuring

Docket #

INSTRUCTIONS: This form shall be completed in duplicate and filed with the Kansas Corporation Commission, 200 Colorado Derby Building, Wichita, Kansas 67202, within 90 days after completion or recompletion of any well. Rules 82-3-130 and 82-3-107 apply.

Information on side two of this form will be held confidential for a period of 12 months if requested in writing and submitted with the form. See rule 82-3-107 for confidentiality in excess of 12 months.

One copy of all wireline logs and drillers time log shall be attached with this form. Submit CP-4 form with all plugged wells. Submit CP-111 form with all temporarily abandoned wells.

All requirements of the statutes, rules, and regulations promulgated to regulate the oil and gas industry have been fully complied with and the statements herein are complete and correct to the best of my knowledge.

Signature [Signature]
Title GEOLOGIST Date 11/5/84

Subscribed and sworn to before me this 5th day of November 1984

Notary Public Elizabeth M. Green
Date Commission Expires 7-8-87

K.C.C. OFFICE USE ONLY
 Letter of Confidentiality Attached
 Wireline Log Received
 Drillers Timelog Received
Distribution
 KCC SWD Rep NGPA
 KGS Plug Other (Specify)