

This form shall be filed in duplicate with the Kansas Corporation Commission, 200 Colorado/Derby Building, Wichita, Kansas 67202, within ten days after the completion of the well, regardless of how the well was completed.

Attach separate letter of request if the information is to be held confidential. If confidential, only file one copy. Information on side one will be of public record and side two will then be held confidential.

Circle one: Oil, Gas, Dry, SWD, OWWO, Injection. Type and complete ALL sections. Applications must be filed for dual completion, commingling, SWD and injection.

Attach wireline logs (i.e. electrical log, sonic log, gamma ray neutron log, etc.). KCC # (316) 263-3238. (Rules 82-2-105 & 82-2-125)

OPERATOR W. E. Carl & Assoc. Petr. Consultants

API NO. 15-135-22,162

ADDRESS Suite 600 - One Main Place

COUNTY Ness

Wichita, KS 67202-1399

FIELD Mount Carmel

\*\*CONTACT PERSON Phyllis Buchanan

PROD. FORMATION Mississippi

PHONE 316-265-9385

LEASE Hinnergardt

PURCHASER Koch Oil Company

WELL NO. #3-27

ADDRESS P. O. Box 2256

WELL LOCATION C SE SW

Wichita, KS 67201

DRILLING Dunne-Gardner Petroleum

660' Ft. from South Line and

CONTRACTOR

1980' Ft. from West Line of

ADDRESS Suite 250, 200 W. Douglas

the SW/4 SEC.27 TWP. 20 RGE. 21W


Wichita, KS 67202

WELL FLAT

PLUGGING NONE

CONTRACTOR

ADDRESS

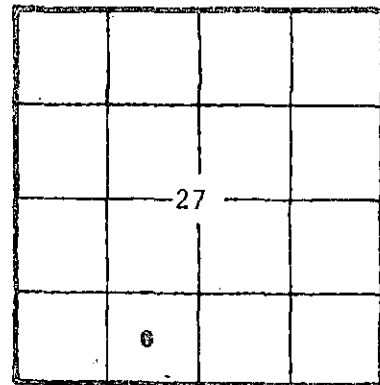

KCC  
KGS  
(Office Use)

TOTAL DEPTH 4500' PBD

SPUD DATE 11-22-81 DATE COMPLETED 12-2-81

ELEV: GR 2228 DF 2226 KB 2223

DRILLED WITH (CABLE) (ROTARY) (AIR) TOOLS

Amount of surface pipe set and cemented 612' DV Tool Used?

A F F I D A V I T

STATE OF KANSAS, COUNTY OF SEDGWICK SS, I,

Phyllis Buchanan OF LAWFUL AGE, BEING FIRST DULY SWORN UPON HIS OATH,

DEPOSES THAT HE IS Agent (FOR) W. E. Carl & Assoc. Petr. Consultants

OPERATOR OF THE Hinnergardt LEASE, AND IS DULY AUTHORIZED TO MAKE

THIS AFFIDAVIT FOR AND ON THE BEHALF OF SAID OPERATOR, THAT WELL NO. #3-27 ON

SAID LEASE HAS BEEN COMPLETED AS OF THE 2nd DAY OF Jan., 19 82, AND THAT

ALL INFORMATION ENTERED HEREIN WITH RESPECT TO SAID WELL IS TRUE AND CORRECT.

FURTHER AFFIANT SAITH NOT.

RECEIVED  
STATE CORPORATION COM.  
MAR - 3 1982  
3-3-82  
CONSERVATION DIVISION  
Wichita, Kansas

(S) Phyllis Buchanan  
PHYLLIS BUCHANAN

SUBSCRIBED AND SWORN BEFORE ME THIS 2nd DAY OF March, 19 82.

SHERRY WAYMAN  
NOTARY PUBLIC  
STATE OF KANSAS  
MY COM. EXPIRES 1-29-85

Sherry Wayman  
NOTARY PUBLIC  
SHERRY WAYMAN

MY COMMISSION EXPIRES:

\*\*The person who can be reached by phone regarding any questions concerning this information. Within 45 days of completion, a witnessed initial test by the Commission is required if the well produces more than 25 BOPD or is located in a Basic Order Pool.